

LAND CORNER RECORDATION CERTIFICATE

Filing Requirement of Act 74, Mich. PA 1970

For Corners In: Cheboygan Located In Corner Code #
(County)

1. Public Land Survey T 36N R 1W D4
T R
2. Property Controlling in Section S T R
S T R
3. Miscellaneous Property in Section S 8 T 36N R 1W 5
S T R


4. Lot No: Recorded Plat:

5. Private Claims:

I, Carl T. Kiiskila, in a field survey on September 1, 2009 do hereby state that under requirements of PA 74, Michigan PA of 1970, the corner points mentioned in lines 1 and 2 above were in conformance with regulations and rules therefore as required in the current manual of survey instructions of the United States Department of the Interior, Bureau of Land Management or by a decree of a Court of Law and/or that the corner points mentioned in lines 3, 4 and 5 above were in conformance with the rules of the Michigan Board of Land Surveyors or by a Decree of a Court of Law; established, re-established, monumented, recovered, found as expressed below:

NOTE: Not more than 2 corners, all in the same town and range, may be recorded on this certificate.

Register of Deeds Stamp & File Number

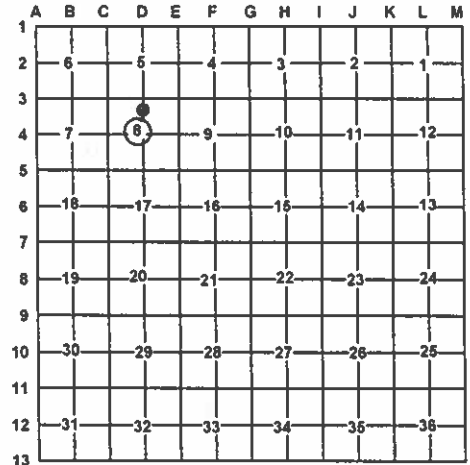

A. Description of original monument and accessories and/or subsequent restoration:

D4 – Center ¼ Corner, Section 8 , T36N,R1W

5 – CN 1/16 Corner Section 8, T36N, R1W

1979 – Survey Map – MDOC – Kenneth J. Ostling, P.S.#10068 – Shows found 1½" pipe at fence corner and distances in all four directions.
1980 – Cert. of Survey – L.405,p.439 – Kenneth J. Ostling, P.S.#10068 – Fd. 1½" pipe with distances E-W and S.

1957 – Survey Map, plan#X-16A-1 – MDOC – W.L.Paddison,P.S.#7256 – Fd. ¾" pipe 20" below pavement. Set ¾" x 20" iron pipe over old pipe even with surface. S4°45'E 33.03' 14" sq. conc. post, E. edge a chiseled arrow; N65°15'W 70.12' 14" sq. conc. post, SE. edge a chiseled arrow; S66°E 73.60' 20" Maple SW root a vert. spike.
1979 – Survey Map – MDOC – Kenneth J. Ostling, P.S.#10068 – Shows iron under blacktop, probable plat corner. Shows distances N-S&E.

B. Description of corner evidence found and/or method applies in restoring or re-establishing corner:

D4 – Center ¼ Corner, Section 8 , T36N,R1W

5 – CN 1/16 Corner Section 8, T36N, R1W

Found 1½ iron pipe at fence corner and int. of fence lines E-W and North. Accepted found 1½" pipe as the best available evidence for the position of the corner. Added ½" plastic cap#33981 in center of pipe. Found no other evidence to dispute the location for the corner.

Found ½" CIR#52464 in mon. box 4' North of E-W C/L blacktop road. Corner is East 30' of C/L blacktop street South. Accepted found CIR as the best available evidence for the position of the corner. Found no other evidence to dispute the location for the corner.

C. Description of monument for corner and accessories established to perpetuate locating the position of the corner:

D4 – Center ¼ Corner, Section 8 , T36N,R1W

5 – CN 1/16 Corner Section 8, T36N, R1W

1½" iron pipe with plastic cap#33981.
Witnesses:
N63°E 13.24' to set N&T on SE side 5" Ash
S47°E 12.50' to set N&T on SW side 4" Ash
S48°W 16.57' to set N&T on SE side 8" Cherry
N50°W 25.82' to set N&T on S side 28" S.Maple
Set Blue Carsonite Post w/location tag 1' North

½" CIR#52464 in mon. box.
Witnesses:
N20°E 24.73' to set N&T on W side 6"x6" sign post
S22°E 41.94' to fd. nail on SW side P.Pole
*S04°W 33.44' to fd. 1" pipe in concrete
*N59°W 70.10' to SE cor. conc. pillar 18" square
N10°E 18.61' to fd. ½" CIR#27452
N06°E 19.88' to set N&T on W side 6" S.Maple

* Previous recorded witness.

Carl T. Kiiskila

Surveyor's Michigan License No.: 33981

2-25-10

