

SURVEY &
REMONUMENTATION

CHEBOYGAN COUNTY REMONUMENTATION CORNER

RECEIVED
MAY 03 1995

LAND CORNER RECORDATION CERTIFICATE

Filing Requirement of Act 74, Mich. P.A. 1970

COMMISSION

DEC 29 1994

For corners in
Cheboygan
(County)

Located In:

Corner Code #

RECEIVED FOR RECORD
of 10:45 O'Clock P M

Joanne H. Hays

CLERK/REGISTER
CHEBOYGAN COUNTY, MICHIGAN

Register of Deeds Stamp & File Number

1. Public Land Survey T 36N R 1W A-12
T R
T R
T R
2. Property Controlling S T R
in Section S T R
3. Miscellaneous S T R
Property in Sec. S T R

4. Lot No. , Recorded Plat
5. Private Claims

I, Richard C. Dunn, in a field survey on October, 19 94,
do hereby certify that under requirements of P.A. 74, Michigan P.A. of 1970, the corner points mentioned
in lines 1 and 2 above were in conformance with regulations and rules therefore as required in the
current manual of survey instructions of the United States Department of the Interior, Bureau of Land
Management or by a decree of a Court of Law and/or that the corner points mentioned in lines 3, 4 and 5
above were in conformance with the rules of the Michigan Board of Land Surveyors or by a Decree of a
Court of Law; established, re-established, monumented, re-monumented, recovered, found as
expressed below:

NOTE: Not more than 4 corners, all in the same town and range, may be recorded
on this certificate.

A. Description of original monument and accessories and/or subsequent restoration:


G.L.O. John Mullett 1840
Set Wood Post
10" Pine N32°E 14 Links
10" Pine S69°W 9 Links

Kenneth Ostling #10068, Nov. 19, 1964
Set 1" pipe w/4" aluminum cap by single
proportionate measurement as recorded
in Liber B, Page 32, Cheboygan County Records.
14" R. Pine S31°E 8.0'
16" R. Pine S83°W 27.4'

B. Description of corner evidence found and/or method applied in restoring or reestablishing corner:

A-12 Fnd. DNR Pipe and cap, set by Ken Ostling as recorded in Liber B, Page 32, Cheboygan County Records

Monica A. Pass

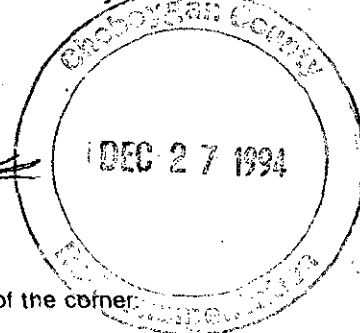

C. Description of monument for corner and accessories established to perpetuate locating the position of the corner:

A-12 Fnd. DNR Pipe and cap as recorded in Liber B, Page 32, Cheboygan County Records
and is accepted as a careful and faithful reestablishment of the position of the original corner.
15" Poplar N38°E 17.65'
24" R. Pine S70°E 3.85'
18" W. Pine S10°W 45.37'
21" R. Pine N80°W 27.66'

LIBER 010 PAGE 93

igned by *Richard C. Dunn*

Date December 15, 1994

urveyor's Michigan License No. 12020

