


LAND CORNER RECORDATION CERTIFICATE
Filing Requirement of Act 74, Mich. PA 1970

For Corners In:
Cheboygan
(County)
Located In
Corner Code #
1. Public Land Survey
2. Property Controlling in Section
3. Miscellaneous Property in Section
4. Lot No:
Recorded Plat:
5. Private Claims:

Register of Deeds Stamp & File Number

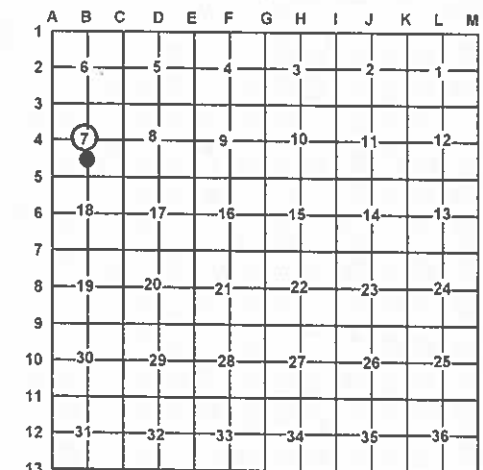

I, Carl T. Kiiskila, in a field survey on September 25, 2006 do hereby state that under requirements of PA 74, Michigan PA of 1970, the corner points mentioned in lines 1 and 2 above were in conformance with regulations and rules therefore as required in the current manual of survey instructions of the United States Department of the Interior, Bureau of Land Management or by a decree of a Court of Law and/or that the corner points mentioned in lines 3, 4 and 5 above were in conformance with the rules of the Michigan Board of Land Surveyors or by a Decree of a Court of Law; established, re-established, monumented, recovered, found as expressed below:
NOTE: Not more than 2 corners, all in the same town and range, may be recorded on this certificate.

A. Description of original monument and accessories and/or subsequent restoration:
B-4 This corner position was not established during the original government survey.
12- This corner position was not established during the original government survey.
B. Description of corner evidence found and/or method applies in restoring or re-establishing corner:
B-4 Established the center of section 7 at intersection of the North-South and East-West one quarter lines.
12- Established the Northeast corner of the Southeast quarter of the Southwest quarter of section 7 as per B.L.M. instructions for the subdivision of a section.

C. Description of monument for corner and accessories established to perpetuate locating the position of the corner:
B-4 Set 5/8" X 32" iron rod with P. S. cap #33981
Wit: 14" Oak S61°W 54.13'
12" Oak N41°W 63.55'
10" R. Pine N20°E 43.31'
16" Oak N71°E 64.60'
Carsonite Post North 1±
12- Set 5/8" X 32" iron rod with P.S. cap #33981
Wit: 9" Oak S13°W 12.37'
16" Oak S76°E 13.91'
5" Maple N18°E 24.57'
6" Oak N59°W 22.04'

Signed by: Carl T. Kiiskila
Surveyor's Michigan License No.: 33981

Date: 12/7/06

