


MICHIGAN  
DEPARTMENT OF CONSERVATION  
FORESTRY DIVISION

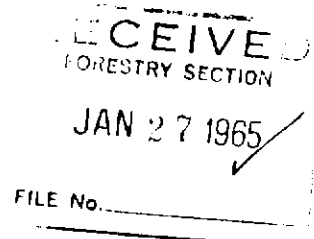

# LAND CORNER RECORD

T. 36 N.R. 2 W.


Cheboygan COUNTY

DESCRIPTION OF CORNER Section corner common to Sections 26 - 27 - 34 - 35

CORNER MONUMENT 1" pipe with 4" aluminum cap

DATE MONUMENT PLACED AND WITNESSED August 28, 1964

WITNESSES TO CORNER.....

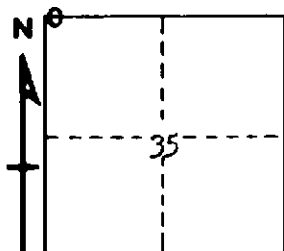

18" R. Pine

N 31 W

44.2'

20" R. Oak

S 73 W

40.8'

AND

CIRCLE CORNER REGISTERED

DESCRIPTION IN DETAIL AS TO HOW CORNER WAS LOCATED AND IDENTIFIED OR RESTORED.

This corner was found while making a survey in this township. Found old stake bottom surrounded by glass, crockery and stone in north edge of E - W township road, in line with fences north and south. No positive identification of OBEs.

SURVEYOR'S SEAL

SIGNED

*Harold J. Brown*  
REGISTERED LAND SURVEYOR #10068

DATE

January 20, 1965