

RECEIVED  
FOR RECORD

00 JAN -3 PM 12:46

1999 CHEBOYGAN COUNTY REMONUMENTATION  
LAND CORNER RECORDATION CERTIFICATE  
Filing Requirement of Act 74, Mich. P.A. 1970

For corners in  
Cheboygan

(County)

Located In:

Corner Code #

1. Public Land Survey

T36N R4W A-8

T36N R4W M-8

T R

T R

2. Property Controlling  
in Section

S T R

S T R

3. Miscellaneous  
Property in Sec.

S T R

S T R

Cheryl Aggysaki  
CLERK/REGISTER  
CHEBOYGAN COUNTY MICHIGAN

MAR 03 2000

Register of Deeds Stamp & File Number

4. Lot No. , Recorded Plat

5. Private Claims

I, Brian K. Fullford, in a field survey on Sept., 1999 do hereby state that under requirements of P.A. 74, Michigan P.A. of 1970, the corner points mentioned in lines 1 and 2 above were in conformance with regulations and rules therefore as required in the current manual of survey instructions of the United States Department of the Interior, Bureau of Land Management or by a decree of a Court of Law and /or that the corner points mentioned in lines 3, 4 and 5 above were in conformance with the rules of the Michigan Board of Land Surveyors or by a Decree of a Court of Law; established, re-established, monumented, recovered, found as expressed below:

NOTE: Not more than 2 corners, all in the same town and range, may be recorded on this certificate.

This corner is also designated as M-8 in T36N-R4W.

	A	B	C	D	E	F	G	H	I	J	K	L	M
1													
2	6		5		4		3		2		1		
3													
4	7		8		9		10		11		12		
5													
6	18		17		16		15		14		13		
7													
8	19		20		21		22		23		24		
9													
10	30		29		28		27		26		25		
11													
12	31		32		33		34		35		36		
13													


A. Description of original monument and accessories and/or subsequent restoration:

1840 Original Survey J. Mullett  
Set 1/4" post  
17" Sugar Maple N7°E  
26" Hemlock S 5 1/2°W  
(No distances given to witness trees)

July 1984 J. Green #15401  
Fnd 1" pipe  
No witnesses given

B. Description of corner evidence found and/or method applied in restoring or reestablishing corner:

Fnd T-bar w/cap #15401  
21' +/- East of centerline extended road to South  
8" Balsam East 5.85' with nail  
T-bar with cap 15401 West 33.00'  
15" Basswood N46°W 52.18' with tag 15401

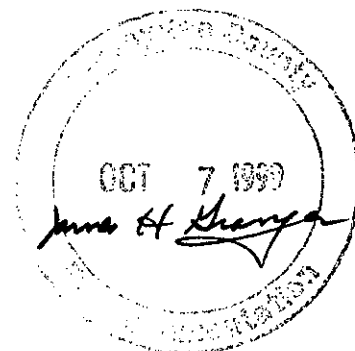

C. Description of monument for corner and accessories established to perpetuate locating the position of the corner:

A-8 Replaced T-bar with cap 15401 with 5/8" X 36" iron bar with remonumentation cap. Position is accepted as a careful and faithful perpetuation of the original corner.

11" Balsam N17°E 16.45' w/old scar Set tag 41099  
8" Balsam East 5.85' w/nail  
T-bar w/cap #15401 West 33.00'  
15" Basswood N46°W 52.18' w/tag #15401

Signed by

B. K. Fullford

Date

12/17/99

Surveyor's Michigan License No.

41099

