

## CHEBOYGAN COUNTY REMONUMENTATION CORNER

JAN 23 1996

## LAND CORNER RECORDATION CERTIFICATE

COMMISSION Filing Requirement of Act 74, Mich. P.A. 1970

For corners in

CHEBOYGAN

(County)

Burt Township

Located In:

Corner Code #

1. Public Land Survey

T 36N R 3W

M-12

T R

T R

T R

2. Property Controlling  
in Section

S T R

S T R

3. Miscellaneous

S T R

Property in Sec.

S T R

4. Lot No. , Recorded Plat

5. Private Claims

RECEIVED  
FOR RECORD

95 SEP 18 AM 9:58

Joanne Spray

CLERK/REGISTER  
CHEBOYGAN COUNTY, MICHIGAN

Register of Deeds Stamp &amp; File Number

I, Ronald Bischer, in a field survey on July 5, 19 95,

do hereby certify that under requirements of P.A. 74, Michigan P.A. of 1970, the corner points mentioned in lines 1 and 2 above were in conformance with regulations and rules therefore as required in the current manual of survey instructions of the United States Department of the Interior, Bureau of Land Management or by a decree of a Court of Law and/or that the corner points mentioned in lines 3, 4 and 5 above were in conformance with the rules of the Michigan Board of Land Surveyors or by a Decree of a Court of Law; established, re-established, monumented, re-monumented, recovered, found as expressed below:

NOTE: Not more than 4 corners, all in the same town and range, may be recorded on this certificate.

	A	B	C	D	E	F	G	H	I	J	K	L	M
2	6	5	4	3	2	1							
3													
4	7	8	9	10	11	12							
5													
6	18	17	16	15	14	13							
7													
8	19	20	21	22	23	24							
9													
10	30	29	28	27	26	25							
11													
12	31	32	33	34	35	36							
13													

A. Description of original monument and accessories and/or subsequent restoration:

1840 Original Survey

John Mullett

Set wood post

14" Pine N45°E 12 lks.

14" Pine S55°W 27 lks.

1946 Survey

Orlando Doyle

Set 1" Axle

18" Oak N57°W 74.15'

22" Oak S61°30'W 60.45'

Power pole N44 E 26.48'

E. Edge of PVT E 0.54'

B. Description of corner evidence found and/or method applied in restoring or reestablishing corner:

Found Concrete Monument, set Cheboygan County Remonumentation cap and monument box.

N57°W 74.15' 28" Red Oak

S61°W 60.45' 26" Red Oak

N40°E 27.63' Power pole - New power pole, old pole location still evident and at correct distance.

LIBER 010 PAGE 108



C. Description of monument for corner and accessories established to perpetuate locating the position of the corner:

Concrete monument with Cheboygan County Remonumentation cap in monument box

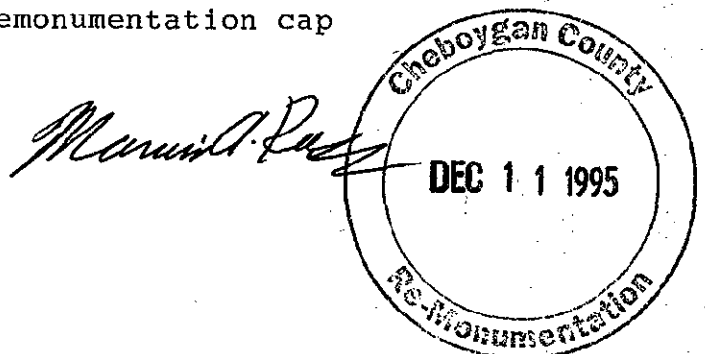
N57°W 74.15' 28" Red Oak

S61°W 60.45' 26" Red Oak

S32°E 59.90' 20" Red Oak

N40°E 27.63' Power pole

Nails with witness tag #22428 used.

Signed by Ronald R. BischerDate July 28, 1995Surveyor's Michigan License No. 22428