

LAND CORNER RECORDATION CERTIFICATE
Filing Requirement of Act 74, Mich. P.A. 1970

For corners in

CHEBOYGAN
(County)

Located in:

Corner Code #

1. Public Land Survey

T___ R___
T___ R___
T___ R___
T___ R___
Other

2. Property Controlling
in Section

S 36 T36N R 3W MC #6

3. Miscellaneous
Property in Sec.

S___ T___ R___
S___ T___ R___

12-22-97
RECEIVED FOR RECORD
at 9:06 O'Clock A M
Jasne Spray

CLERK/REGISTER
CHEBOYGAN COUNTY, MICHIGAN

Register of Deeds Stamp & File Number

4. Lot No. _____, Recorded Plat _____
5. Private Claims _____

I, Ronald Bischer, in a field survey on Oct 1, 1997 do hereby state that under requirements of P.A. 74, Michigan P.A. of 1970, the corner points mentioned in lines 1 and 2 above were in conformance with regulations and rules therefore as required in the current manual of survey instructions of the United States Department of the Interior, Bureau of Land Management or by a decree of a Court of Law and/or that the corner points mentioned in lines 3, 4 and 5 above were in conformance with the rules of the Michigan Board of Land Surveyors or by a Decree of a Court of Law; established, re-established, monumented, recovered, found as expressed below:


NOTE: Not more than 2 corners, all in the same town and range, may be recorded on this certificate.

	A	B	C	D	E	F	G	H	I	J	K	L	M
1													
2	6			5			4			3		2	1
3													
4	7			8			9			10		11	12
5													
6	18			17			16			15		14	13
7													
8	19			20			21			22		23	24
9													
10	30			29			28			27		26	25
11													
12	31			32			33			34		35	36
13													

A. Description of original monument and accessories and/or subsequent restoration:

MC Between K-12 & K-13
GLO Notes
Harvey Mellen
1855 Resurvey
Set post
9" Aspen N74° E 35 lks
10" Cedar N32° W 15 lks

1959 Dean DelaMater #5778
Set Concrete Monument

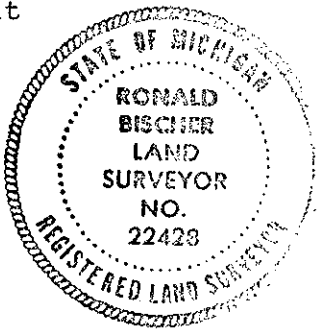

B. Description of corner evidence found and/or method applied in restoring or reestablishing corner:

MC
Found Concrete Monument
Set Remon. Cap on Concrete monument

SURVEY &
REMONUMENTATION


FEB 26 1998

SECTION

C. Description of monument for corner and accessories established to perpetuate locating the position of the corner:

MC
Remon cap on Concrete monument
S83° E 21.83' Concrete monument
N50° E 34.58' 4" Cedar
N55° W 40.65' Conc. Mon.
N54° W 71.50' 18" Cedar

LIBER 011 PAGE 54

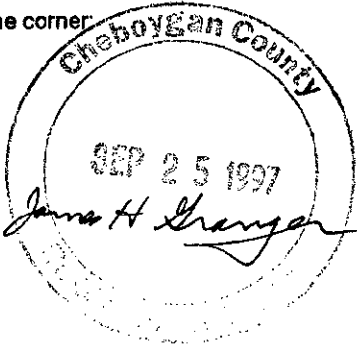

Signed by Ronald R. Bischer
Surveyor's Michigan License No. 22428

Date Oct. 10, 1997