

SURVEY & REMONUMENTATION
187
MAY 2 1999

1998

SECTION

CHEBOYGAN COUNTY REMONUMENTATION
LAND CORNER RECORDATION CERTIFICATE
Filing Requirement of Act 74, Mich. P.A. 1970

For corners in
Cheboygan
(County)

Located In:	Corner Code #
1. Public Land Survey	T ^{36N} R ^{3W} <u>B</u>
	T R
	T R
	T R
2. Property Controlling in Section	S T R
	S T R
3. Miscellaneous Property in Sec.	S T R
	S T R

RECEIVED FOR RECORD 1-8-99
at 9:08 O'Clock A M
Joanne Spray
CLERK/REGISTER
CHEBOYGAN COUNTY, MICHIGAN
Register of Deeds Stamp & File Number

4. Lot No. _____, Recorded Plat _____
5. Private Claims _____

I, Brian K. Fullford, in a field survey on June, 1998 do hereby state that under requirements of P.A. 74, Michigan P.A. of 1970, the corner points mentioned in lines 1 and 2 above were in conformance with regulations and rules therefore as required in the current manual of survey instructions of the United States Department of the Interior, Bureau of Land Management or by a decree of a Court of Law and /or that the corner points mentioned in lines 3, 4 and 5 above were in conformance with the rules of the Michigan Board of Land Surveyors or by a Decree of a Court of Law; established, re-established, monumented, recovered, found as expressed below:

NOTE: Not more than 2 corners, all in the same town and range, may be recorded on this certificate.


	A	B	C	D	E	F	G	H	I	J	K	L	M
1													
2	6		5			4		3		2		1	
3							•						
4	7		8			9		10		11		12	
5													
6	18		17			16		15		14		13	
7													
8	19		20			21		22		23		24	
9													
10	30		29			28		27		26		25	
11													
12	31		32			33		34		35		36	
13													

A. Description of original monument and accessories and/or subsequent restoration:

1855 Harvey Mellon
Resurvey
Set meander post
20" Maple N 33° W 28 lks
10" W. Ash N 13° E 47 lks
15.6 chains (1029.6' from E 1/4 corner of Section 4, T36N-R3W) Intersected Burt Lake

B. Description of corner evidence found and/or method applied in restoring or reestablishing corner:

Fnd no evidence of any old or existing corner.
Set WCMC on extension of line from NW corner
Section 3 and West 1/4 corner of Section 3, per
GLO.

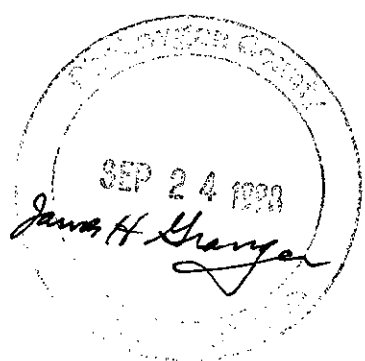

C. Description of monument for corner and accessories established to perpetuate locating the position of the corner:

G2-G3 Placed 5/8" rebar with remonumentation cap, and position is accepted as a careful and faithful re-establishment of a witness corner to the original corner. Witness corner is 41.0 feet North of original meander corner.

Intersected Burt Lake 988.65' from East 1/4 of Sec 4, T36N-R3W.
6" Ash N 69° E 13.75' Tag #26466
12" Birch S 72° E 7.25' Tag #26466
12" Cedar S 14° W 4.35' Tag #26466
8" Ash S 87° W 22.61' Tag #26466
Waters edge 32' south



Signed by *B. K. Fullford*
Surveyor's Michigan License No. 41099

Date 11/23/98