

RECEIVED
FOR RECORD

1999 CHEBOYGAN COUNTY REMONUMENTATION
LAND CORNER RECORDATION CERTIFICATE
Filing Requirement of Act 74, Mich. P.A. 1970

00 JAN -3 PM 12:38

For corners in
Cheboygan

(County)

Located In:

Corner Code #

1. Public Land Survey

T^{36N} R^{3W}

14

2. Property Controlling
in Section

S

T

R

3. Miscellaneous
Property in Sec.

S

T

R

Deby Pyzyrski
CLERK/REGISTER
CHEBOYGAN COUNTY MICHIGAN

MAR 03 2000

SECTION
Register of Deeds Stamp & File Number

4. Lot No. _____, Recorded Plat _____

5. Private Claims _____

I, Brian K. Fullford, in a field survey on October, 1999, do hereby state that under requirements of P.A. 74, Michigan P.A. of 1970, the corner points mentioned in lines 1 and 2 above were in conformance with regulations and rules therefore as required in the current manual of survey instructions of the United States Department of the Interior, Bureau of Land Management or by a decree of a Court of Law and/or that the corner points mentioned in lines 3, 4 and 5 above were in conformance with the rules of the Michigan Board of Land Surveyors or by a Decree of a Court of Law; established, re-established, monumented, recovered, found as expressed below:

NOTE: Not more than 2 corners, all in the same town and range, may be recorded on this certificate.

A	B	C	D	E	F	G	H	I	J	K	L	M
1												
2	6	5	4	3	2	1						
3												
4	7	8	9	10	11	12						
5												
6	18	17	16	15	14	13						
7												
8	19	20	21	22	23	24						
9												
10	30	29	28	27	26	25						
11												
12	31	32	33	34	35	36						
13												

A. Description of original monument and accessories and/or subsequent restoration:

Resurvey 1855
Set meander post
(31.50 chains N. of cor. E-9)
10" Elm S34°W 12 Lks.
7" Cedar S72°W 29 Lks.

May 1950 J. Doyle
Shows ¾" pipe
No witnesses given

Dec. 1987 J. O'Neill Rls. #30095
Set 5/8" rebar w/cap #30095
16" Cedar N46°W 51.78'
36" Basswood S44°W 5.10'
16" Maple S30°E 48.96'
NE Hse cor. N80°W 36.62'


Sept. 1990 R. Oelke Rls.
#33983
Fnd original conc. Mon.
Not accepted as meander
corner
Fnd 5/8" rod w/cap #30095
Used as witnesses corner to
meander corner w/O'Neill
witnesses per L. 1, Pg. 410

Dec. 1990 R. Oelke Rls.
#33983
Fnd 5/8" rod #30095 as the
witness corner to the
meander cor. per L. 1, Pg.
410

July 1993 J. Granger Rls.
16041
Fnd 5/8" iron w/cap 30095
Per LCRC Liber 1, Pg 410

B. Description of corner evidence found and/or method applied in restoring or reestablishing corner:

Fnd conc mon @ base of 5' bank leaning NE edge of water 1' North
Fnd 5/8" bar w/cap #30095 (witness corner to meander corner)

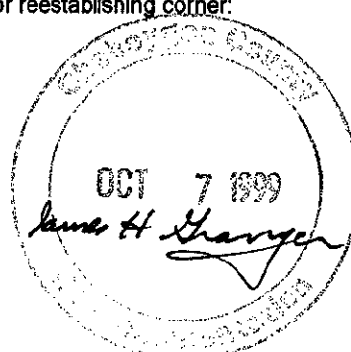

C. Description of monument for corner and accessories established to perpetuate locating the position of the corner:

E8-E9 Set remonumentation cap on 5/8" bar as witness corner to meander corner, and position is accepted as a careful and faithful re-establishment of a witness corner to the original corner.

Witness corner is 1870.4 feet North of Southwest Section corner
Witness corner is 209 feet South of original meander corner
45" Basswood S45°W 5.10' Set tag 41099
18" Maple S22°E 49.95' Set tag 41099
NE Cor Hse. S89°W 36.70'
5/8" B & C 30095 North 46.93'
Edge of water North 58.0'

Signed by

B. K. Fullford

Surveyor's Michigan License No.

41099

Date

12/17/99

