

SURVEY &  
REMONUMENTATION

105 1993

CHEBOYGAN COUNTY REMONUMENTATION CORNER  
LAND CORNER RECORDATION CERTIFICATE  
Filing Requirement of Act 74, Mich. P.A. 1970

COMMISSION

For corners in

CHEBOYGAN  
(County)

Located In:

Corner Code ##

1. Public Land Survey T 37N R 1E A-1  
T \_\_\_\_\_ R \_\_\_\_\_  
T \_\_\_\_\_ R \_\_\_\_\_  
T \_\_\_\_\_ R \_\_\_\_\_  
T \_\_\_\_\_ R \_\_\_\_\_
2. Property Controlling S \_\_\_\_\_ T \_\_\_\_\_ R \_\_\_\_\_  
in Section S \_\_\_\_\_ T \_\_\_\_\_ R \_\_\_\_\_  
3. Miscellaneous S \_\_\_\_\_ T \_\_\_\_\_ R \_\_\_\_\_  
Property in Sec. S \_\_\_\_\_ T \_\_\_\_\_ R \_\_\_\_\_
4. Lot No. \_\_\_\_\_, Recorded Plat \_\_\_\_\_  
5. Private Claims \_\_\_\_\_

RECEIVED  
FOR RECORD

93 DEC 22 AM 9: 53

*Joanna Gray*  
CLERK/REGISTER  
CHEBOYGAN COUNTY, MICHIGAN

Register of Deeds Stamp & File Number

I, Ronald R. Bischer, in a field survey on September 23, 19 93,  
do hereby certify that under requirements of P.A. 74, Michigan P.A. of 1970, the corner points mentioned  
in lines 1 and 2 above were in conformance with regulations and rules therefore as required in the  
current manual of survey instructions of the United States Department of the Interior, Bureau of Land  
Management or by a decree of a Court of Law and/or that the corner points mentioned in lines 3, 4 and 5  
above were in conformance with the rules of the Michigan Board of Land Surveyors or by a Decree of a  
Court of Law; established, re-established, monumented, re-monumented, recovered, found as  
expressed below:

NOTE: Not more than 4 corners, all in the same town and range, may be recorded  
on this certificate.

A. Description of original monument and accessories and/or subsequent restoration:

A-1

Original Survey - June 1840

John Hodgson set Wood Post

18" Pine S20°W 20 links

18" Pine S67°E 40 links

1933+ - Marcus Schaaf

set 4" Pipe from both O.B.T.

stumps

1963 - Kenneth Ostling

Found 4" Pipe & possible O.B.T. stumps

12" R. Pine S37°W 3.0'

12" R. Pine N11°E 25.1'

1964 - Kenneth Larsen

4" Pipe - same witnesses as above

B. Description of corner evidence found and/or method applied in restoring or reestablishing corner:

A-1

Found 4" Pipe and both O.B.T. stumps

Both Ostling witnesses in place

12" R. Pine S37°W 3.0'

12" R. Pine N11°E 25.1'

Set Cheboygan County Remonumentation Monument inside  
of existing 4" Pipe.

LIBER .010 PAGE 17

C. Description of monument for corner and accessories established to perpetuate locating the position of the corner:

A-1

Cheboygan County Remonumentation Monument in 4" Pipe



N11°E 25.55' 18" Red Pine

S37°W 3.63' 20" Red Pine

S48°E 21.69' 5" Red Pine

N60°W 55.09' 14" Red Pine

Set nail with witness tag #22428 in witnesses.

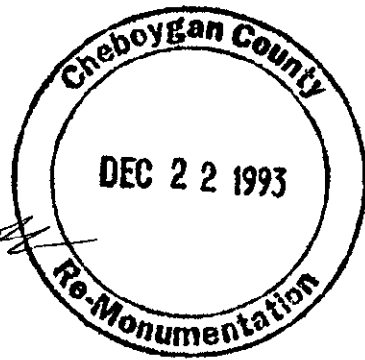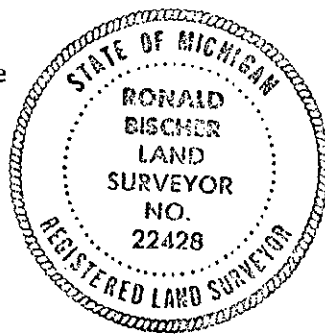

Signed by Ronald R. Bischer

Date 12-03-93

Surveyor's Michigan License No. 22428