

SURVEY & REMONUMENTATION

1993

COMMISSION

CHEBOYGAN COUNTY REMONUMENTATION CORNER LAND CORNER RECORDATION CERTIFICATE Filing Requirement of Act 74, Mich. P.A. 1970

For corners in

CHEBOYGAN
(County)

Located In:

Corner Code ##

- | | | | | | |
|---------------------------------------|---|-----|---|----|------|
| 1. Public Land Survey | T | 37N | R | 1E | A-10 |
| | T | | R | | |
| | T | | R | | |
| | T | | R | | |
| 2. Property Controlling
in Section | S | | T | R | |
| | S | | T | R | |
| 3. Miscellaneous
Property in Sec. | S | | T | R | |
| | S | | T | R | |

RECEIVED
FOR RECORD

93 DEC 22 AM 10:43

James Gray

CLERK/REGISTER
CHEBOYGAN COUNTY, MICHIGAN
Register of Deeds Stamp & File Number

4. Lot No. _____, Recorded Plat _____
5. Private Claims _____

I, Ronald R. Bischer, in a field survey on September 20, 19 93,
do hereby certify that under requirements of P.A. 74, Michigan P.A. of 1970, the corner points mentioned
in lines 1 and 2 above were in conformance with regulations and rules therefore as required in the
current manual of survey instructions of the United States Department of the Interior, Bureau of Land
Management or by a decree of a Court of Law and/or that the corner points mentioned in lines 3, 4 and 5
above were in conformance with the rules of the Michigan Board of Land Surveyors or by a Decree of a
Court of Law; established, re-established, monumented, re-monumented, recovered, found as
expressed below:

**NOTE: Not more than 4 corners, all in the same town and range, may be recorded
on this certificate.**

A. Description of original monument and accessories and/or subsequent restoration:

A-10

Original Survey - June 21 1840

John Hodgson set Wood Post

7" Balsam S29 E 10 links

6" Balsam N54 W 10 links

1854 Resurvey


Geo. H. Cannon found and used
wood post set by John Hodgson

1967 - Marvin Ross

Set 1- $\frac{1}{2}$ " pipe at fence intersection.

No record of witnesses set.

	A	B	C	D	E	F	G	H	I	J	K	L	M
2	6	5	4	3	2	1							
3													
4	7	8	9	10	11	12							
5													
6	18	17	16	15	14	13							
7													
8	19	20	21	22	23	24							
9													
10	30	29	28	27	26	25							
11													
12	31	32	33	34	35	36							
13													

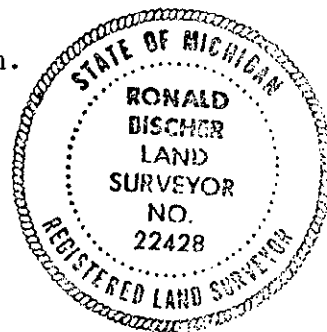

B. Description of corner evidence found and/or method applied in restoring or reestablishing corner:

A-10

Found 1- $\frac{1}{2}$ " Pipe

S15 E 12.45' 5" Aspen

found spike in the side of dead 5" Aspen

S65 E 33.90' 6" Aspen

found spike in the side of dead 6" Aspen

Replaced 1- $\frac{1}{2}$ " Pipe with Cheboygan County Remonumentation Monument

LIBER 010 PAGE 24

C. Description of monument for corner and accessories established to perpetuate locating the position of the corner:

A-10

Cheboygan County Remonumentation Monument

N17 W 28.18' 13" Black Ash


S59 W 27.16' 8" Balsam

N48 W 22.28' 10" Twin Cedar

S26 E 28.22' 8" Cedar

Set nail with witness tag #22428 in witnesses.

Marvin Ross

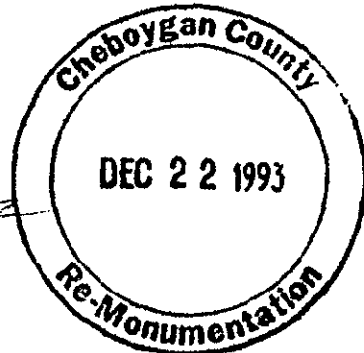

Signed by Ronald R. Bischer

Date 12-03-93

Surveyor's Michigan License No. 22428