

SURVEY & REMONUMENTATION

CHEBOYGAN COUNTY REMONUMENTATION CORNER

MAY 03 1995

LAND CORNER RECORDATION CERTIFICATE

Filing Requirement of Act 74, Mich. P.A. 1970

RECEIVED
FOR RECORD

94 NOV 22 AM 10:24

Joanne Spray

CLERK/REGISTER
CHEBOYGAN COUNTY, MICHIGAN

For corners in

CHEBOYGAN
(County)

COMMISSION

Located In:

Corner Code ##

- | | | | | | |
|------------------------------------|---|-----|---|----|-----|
| 1. Public Land Survey | T | 37N | R | 1W | A-7 |
| | T | | R | | |
| | T | | R | | |
| | T | | R | | |
| 2. Property Controlling in Section | S | | T | R | |
| | S | | T | R | |
| 3. Miscellaneous Property in Sec. | S | | T | R | |
| | S | | T | R | |

Register of Deeds Stamp & File Number

4. Lot No. _____, Recorded Plat _____
5. Private Claims _____

	A	B	C	D	E	F	G	H	I	J	K	L	M
2	6		5		4		3		2		1		
3													
4	7		8		9		10		11		12		
5													
6	18		17		16		15		14		13		
7													
8	19		20		21		22		23		24		
9													
10	30		29		28		27		26		25		
11													
12	31		32		33		34		35		36		
13													

I, Ronald Bischer, in a field survey on July 6, 19 94, do hereby certify that under requirements of P.A. 74, Michigan P.A. of 1970, the corner points mentioned in lines 1 and 2 above were in conformance with regulations and rules therefore as required in the current manual of survey instructions of the United States Department of the Interior, Bureau of Land Management or by a decree of a Court of Law and/or that the corner points mentioned in lines 3, 4 and 5 above were in conformance with the rules of the Michigan Board of Land Surveyors or by a Decree of a Court of Law; established, re-established, monumented, re-monumented, recovered, found as expressed below:

NOTE: Not more than 4 corners, all in the same town and range, may be recorded on this certificate.

A. Description of original monument and accessories and/or subsequent restoration:

- | | | |
|-------------------------------------|----------------------------------|--------------------------|
| June 1840 GLO Survey - John Mullett | N08°E 142.21' | Tele pole |
| Set Wood Post | S80°E 87.00' | 12" Elm |
| Hemlock 16" S49°W 8 links | N65°W 102.76' | 5" Birch |
| Cedar 12" N49°E 8 links | January 1964 - Kenneth R. Larsen | 1" Iron |
| 03-01-61 - Dean DeLaMater | Same witnesses as above | |
| Found 1½" Rod & 3/4" Rod | 02-17-88 - James H. Granger | Found ½" Rod in Mon. Box |
| S60°E 71.20' Tele. pole | N48°E 94.54' | Base steel post |
| N15°E 142.60' Tele. pole | S68°E 70.90' | Base steel post |
| N65°W 106.40' Power pole | | |
| July 1962 - M.A. Koivisto | | |


S67°W 55.35' Base steel post
N38°W 13.90' Base steel post
03-01-89 - James H. Granger same as above

B. Description of corner evidence found and/or method applied in restoring or reestablishing corner:

- ½" Rod and pieces of a monument box
N38°W 13.90' Base steel post

Measured position of corner from 02-17-88 Granger survey, and confirmed that corner is the same as recorded then.

Replaced ½" Rod with Cheboygan County Remonumentation Monument

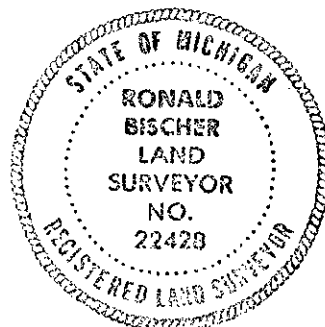


C. Description of monument for corner and accessories established to perpetuate locating the position of the corner:

- Cheboygan County Remonumentation Monument
N38°W 13.90' Base steel post
N11°E 144.04' Power pole
S83°E 59.12' Base steel sign post
S30°E 120.40' Power pole

LIBER 010 PAGE 73

Marvin A. Rose

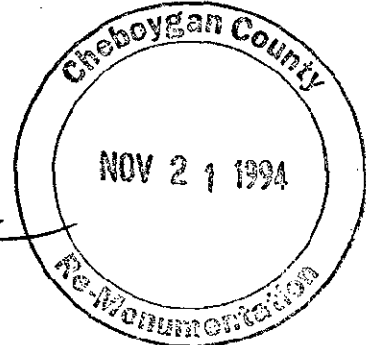

Signed by Ronald R. Bischer

Date Oct. 25, 1994

Surveyor's Michigan License No. 22428