

MAY 6 1967

LAND CORNER RECORDATION CERTIFICATE
Filing Requirement of Act 74, Mich. P.A. 1970

CHEBOYGAN

Located In: Corner Code #

1. Public Land Survey

T 37N R 3W

M-7

T 37 R 2W

A-7

2. Property Controlling
in Section

S T R

S T R

3. Miscellaneous
Property in Sec.

S T R

S T R

4. Lot No. , Recorded Plat

5. Private Claims

I, JAMES H. GRANGER, in a field survey on SEPTEMBER 24, 1996 do hereby state that under requirements of P.A. 74, Michigan P.A. of 1970, the corner points mentioned in lines 1 and 2 above were in conformance with regulations and rules therefore as required in the current manual of survey instructions of the United States Department of the Interior, Bureau of Land Management or by a decree of a Court of Law and /or that the corner points mentioned in lines 3, 4 and 5 above were in conformance with the rules of the Michigan Board of Land Surveyors or by a Decree of a Court of Law; established, re-established, monumented, recovered, found as expressed below:

NOTE: Not more than 2 corners, all in the same town and range, may be recorded on this certificate.


A	B	C	D	E	F	G	H	I	J	K	L	M
1												
2	6	5	4	3	2	1						
3												
4	7	8	9	10	11	12						
5												
6	18	17	16	15	14	13						
7												
8	19	20	21	22	23	24						
9												
10	30	29	28	27	26	25						
11												
12	31	32	33	34	35	36						
13												

A. Description of original monument and accessories and/or subsequent restoration:

1840 Original Survey Set wood post 12" Beech N11°W 27 lks
John Mullett 12" Beech S84°E 17 lks
1984 Survey Found 1 1/4" pipe
Orlando Doyle # 7319
1988 LCRC Found 1 1/4" pipe
James H. Granger # 16041
1994 LCRC Found 1 1/4" pipe
Norman Quaine # 33984

B. Description of corner evidence found and/or method applied in restoring or reestablishing corner:

Found 1 1/4" pipe and four witnesses.

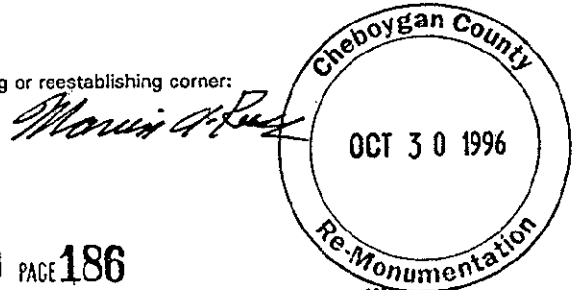


LIBER 010 PAGE 186

C. Description of monument for corner and accessories established to perpetuate locating the position of the corner, also corner A-7, T37N, R2W

Set 5/8" x 30" rebar inside 1 1/4" pipe with Remonumentation Cap

1 1/4" Pipe	N48°E	49.31'	Fd tag
Power Pole	S25°E	64.00'	Fd tag
Anchor Pole	N46°W	56.08'	Fd tag
Fence Post	S59°W	55.30'	Set nail w/tag

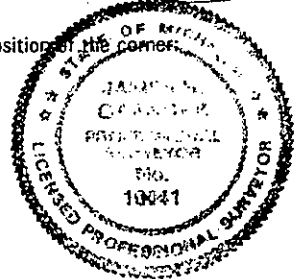

Signed by James H. Granger
Surveyor's Michigan License No. 16041

Date 10-18-96