

CHEBOYGAN COUNTY REMONUMENTATION CORNER

LAND CORNER RECORDATION CERTIFICATE
Filing Requirement of Act 74, Mich. P.A. 1970

For corners in

CHEBOYGAN Located In: Corner Code #
(County)

1. Public Land Survey T 37NR 2W D-3
T R
T R
T R
2. Property Controlling S T R
in Section S T R
3. Miscellaneous S T R
Property in Sec. S T R

4. Lot No. , Recorded Plat
5. Private Claims

JAMES H. GRANGER, in a field survey on JULY 15, 19 97 do hereby state that under requirements of P.A. 74, Michigan P.A. of 1970, the corner points mentioned in lines 1 and 2 above were in conformance with regulations and rules therefore as required in the current manual of survey instructions of the United States Department of the Interior, Bureau of Land Management or by a decree of a Court of Law and /or that the corner points mentioned in lines 3, 4 and 5 above were in conformance with the rules of the Michigan Board of Land Surveyors or by a Decree of a Court of Law; established, re-established, monumented, recovered, found as expressed below:

NOTE: Not more than 2 corners, all in the same town and range, may be recorded on this certificate.

A. Description of original monument and accessories and/or subsequent restoration:

D-3 1855 Original Survey Set wood post 14" Sugar S55°W 5 lks
Harvey Mellen 14" Hemlock South 11 lks

SURVEY &
REMONUMENTATION

FEB 26 1998

SECTION

B. Description of corner evidence found and/or method applied in restoring or reestablishing corner:


B-3 Found 1/2" iron with cap (illegible) that fit well with single proportionate measure between the SE and SW Section corners. Replaced with 5/8" rebar and remonumentation cap.

C. Description of monument for corner and accessories established to perpetuate locating the position of the corner:

B-3 5/8" rebar and Remonumentation Cap
14" Poplar S28°W 23.23' Set tag #16041
Twin 4" Maple S28°E 25.18' Set tag #16041
12" Maple N30°E 27.49' Set tag #16041
Twin 12" Maple N41°W 36.45' Set tag #16041

LIBER 011 PAGE 28

Signed by James H. Granger Date Nov. 17, 1997 Surveyor's Michigan
License No. 16041

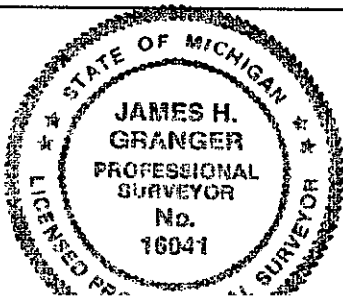

FORM APPROVED BY MICHIGAN STATE BOARD OF PROFESSIONAL SURVEYORS, JAN. 23, 1971
REVISED 14, 1976

REVISED JAN., 1983
REVISED OCT., 1996

RECEIVED FOR RECORD 12-18-97
at 11:24 O'Clock A.M.

Joanne Spray

CLERK/REGISTER
CHEBOYGAN COUNTY, MICHIGAN
Register of Deeds Stamp & File Number

	A	B	C	D	E	F	G	H	I	J	K	L	M
1													
2	6			5		4		3		2		1	
3													
4	7			8		9		10		11		12	
5													
6	18			17		16		15		14		13	
7													
8	19			20		21		22		23		24	
9													
10	30			29		28		27		26		25	
11													
12	31			32		33		34		35		36	
13													

