

## CHEBOYGAN COUNTY REMONUMENTATION CORNER

LAND CORNER RECORDATION CERTIFICATE  
Filing Requirement of Act 74, Mich. P.A. 1970

For corners in

CHEBOYGAN  
(County)

Located In:

Corner Code #

## 1. Public Land Survey

38N 2W  
T 37NR 2W1-13  
1-12. Property Controlling  
in Section

S T R

3. Miscellaneous  
Property in Sec.

S T R

4. Lot No. \_\_\_\_\_, Recorded Plat \_\_\_\_\_  
5. Private Claims \_\_\_\_\_RECEIVED FOR RECORD 12-18-97  
at 11:30 A.M. '97

Joanne Spray

CLERK/REGISTER  
CHEBOYGAN COUNTY, MICHIGAN

Register of Deeds Stamp &amp; File Number

I, JAMES H. GRANGER, in a field survey on JULY 15, 19 97 do hereby state that under requirements of P.A. 74, Michigan P.A. of 1970, the corner points mentioned in lines 1 and 2 above were in conformance with regulations and rules therefore as required in the current manual of survey instructions of the United States Department of the Interior, Bureau of Land Management or by a decree of a Court of Law and for that the corner points mentioned in lines 3, 4 and 5 above were in conformance with the rules of the Michigan Board of Land Surveyors or by a Decree of a Court of Law; established, re-established, monumented, recovered, found as expressed below:

NOTE: Not more than 2 corners, all in the same town and range, may be recorded on this certificate.

## A. Description of original monument and accessories and/or subsequent restoration:


I-1 1840 Original Survey John Mullett	Set wood post	16" Hemlock N45°E 37 lks 12" Hemlock N62°W 12 lks
1957 Survey Orlando Doyle #7319	Monument Shown	
1960 Survey Orlando Doyle #7319	Monument Shown	
1963 LCRC Kenneth Larsen #10695	1/2" pipe	
1977 Survey Orlando Doyle #7319	Metal Monument	

SURVEY &  
REMONUMENTATION

FEB 26 1998

SECTION

	A	B	C	D	E	F	G	H	I	J	K	L	M
1													
2	6			5			4		3		2		1
3													
4	7			8			9		10		11		12
5													
6	10			17			16		15		14		13
7													
8	19			20			21		22		23		24
9													
10	30			29			28		27		26		25
11													
12	31			32			33		34		35		36
13													

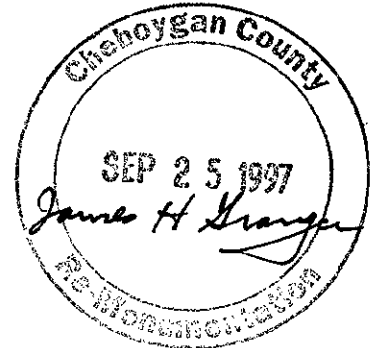


## B. Description of corner evidence found and/or method applied in restoring or reestablishing corner:

I-1 Found 1/2" pipe in Monument Box. Replaced with 5/8" rebar and remonumentation cap.

## C. Description of monument for corner and accessories established to perpetuate locating the position of the corner:

I-1 5/8" rebar and Remonumentation Cap in Monument Box

5" Twin Ash	S79°W	96.51'	Set tag #16041
12" Poplar	N65°W	81.46'	Set tag #16041
12" Cedar	S41°E	50.25'	Set tag #16041
PP	N80°E	130.40'	Set tag #16041

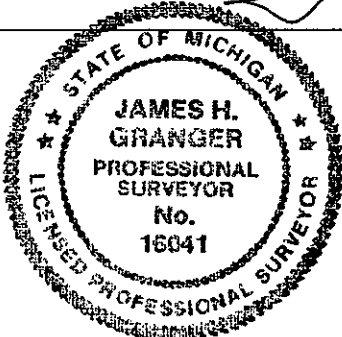Signed by James H. Granger  
License No. 16041Date Nov 17, 1997 Surveyor's MichiganFORM APPROVED BY MICHIGAN STATE BOARD OF PROFESSIONAL SURVEYORS, JAN. 23, 1971  
REVISED 14, 1975REVISED JAN., 1983  
REVISED OCT., 1996

LIBER 011 PAGE 40