

SURVEY & MONUMENTATION

JAN 23 1996

CHEBOYGAN COUNTY REMONUMENTATION LAND CORNER RECORDATION CERTIFICATE Filing Requirement of Act 74, Mich. P.A. 1970

COMMISSION

For corners in
Cheboygan
(County)

Located In:

Corner Code #

1. Public Land Survey

T 37N R 2W

K-9

2. Property Controlling
in Section

S T R

3. Miscellaneous
Property in Sec.

S T R

4. Lot No. , Recorded Plat

5. Private Claims

RECEIVED
FOR RECORD

95 DEC 11 PM 4:21

James H. Granger

CLERK/REGISTER
CHEBOYGAN COUNTY, MICHIGAN

Register of Deeds Stamp & File Number

I, James H. Granger in a field survey on August 4, 19 95,
do hereby certify that under requirements of P.A. 74, Michigan P.A. of 1970, the corner points mentioned
in lines 1 and 2 above were in conformance with regulations and rules therefore as required in the
current manual of survey instructions of the United States Department of the Interior, Bureau of Land
Management or by a decree of a Court of Law and/or that the corner points mentioned in lines 3, 4 and 5
above were in conformance with the rules of the Michigan Board of Land Surveyors or by a Decree of a
Court of Law; established, re-established, monumented, re-monumented, recovered, found as
expressed below:

NOTE: Not more than 4 corners, all in the same town and range, may be recorded
on this certificate.

A. Description of original monument and accessories and/or subsequent restoration:

1840 Original Survey Set wood post 16" Birch N71¹/₂° W 30 lks 16" Sugar S20°W 8lks
John Mullett


1900 Co. Surveyor
1988 LCRC James H. Granger # 16041 1"rod
1992 LCRC James H. Granger # 16041 1"rod
1995 Survey James H. Granger # 16041 1"rod

B. Description of corner evidence found and/or method applied in restoring or reestablishing corner:

Found 1" rod in monument box. Replaced with 5/8" rebar and remonumentation cap

LIBER 010 PAGE 123


Morris C. Ross

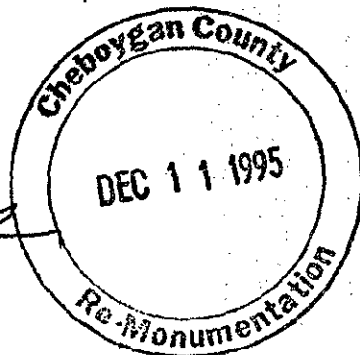

C. Description of monument for corner and accessories established to perpetuate locating the position of the corner:

5/8" rebar and remonumentation cap in monument box.

Grand rail post	N70°E	28.48	Fd tag
Grand rail post	S89°E	25.25	Fd tag
Power pole	N18°W	54.74	Fd tag
Power pole	S29°W	66.09	Fd Tag

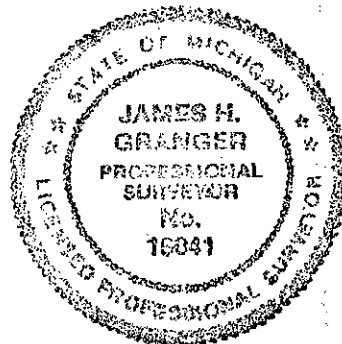

Signed by James H. Granger

Date 10/23/95

Surveyor's Michigan License No. 16041