

SURVEY & REMONUMENTATION

CHEBOYGAN COUNTY REMONUMENTATION

MAY 03 1995

LAND CORNER RECORDATION CERTIFICATE

COMMISSION

Filing Requirement of Act 74, Mich. P.A. 1970

RECEIVED
FOR RECORD

94 NOV 22 AM 9: 53

Joanne Spring

CLERK/REGISTER
CHEBOYGAN COUNTY, MICHIGAN

For corners in

Cheboygan

(County)

Located In:

Corner Code #

1. Public Land Survey

T 38N R 1W

C-13

T R

T R

T R

T R

2. Property Controlling
in Section

S T R

S T R

3. Miscellaneous
Property in Sec.

S T R

S T R

Register of Deeds Stamp & File Number

4. Lot No. , Recorded Plat

5. Private Claims

	A	B	C	D	E	F	G	H	I	J	K	L	M
2	6	5	4	3	2	1							
3													
4	7	8	9	10	11	12							
5													
6	18	17	16	15	14	13							
7													
8	19	20	21	22	23	24							
9													
10	30	29	28	27	26	25							
11													
12	31	32	33	34	35	36							
13													

I, James H. Granger, in a field survey on August 15, 19 94, do hereby certify that under requirements of P.A. 74, Michigan P.A. of 1970, the corner points mentioned in lines 1 and 2 above were in conformance with regulations and rules therefore as required in the current manual of survey instructions of the United States Department of the Interior, Bureau of Land Management or by a decree of a Court of Law and/or that the corner points mentioned in lines 3, 4 and 5 above were in conformance with the rules of the Michigan Board of Land Surveyors or by a Decree of a Court of Law; established, re-established, monumented, re-monumented, recovered, found as expressed below:

NOTE: Not more than 4 corners, all in the same town and range, may be recorded on this certificate.


A. Description of original monument and accessories and/or subsequent restoration:

1840 Original Survey Set wood post, 10" Fir N39°W 32 lks, 8" Cedar N65°E 24 lks
John Mullett
1874 John McDonald Plat Monument
1960 Dean DeLameter #05778 Plat Monument
1992 James H. Granger #16041 Fd T-iron

B. Description of corner evidence found and/or method applied in restoring or reestablishing corner:

Fd. T-iron. Fd 3 witness. Reset 5/8" rebar w/aluminum cap in Monument Box. Replaced 2 of the old witnesses.

Monument Box

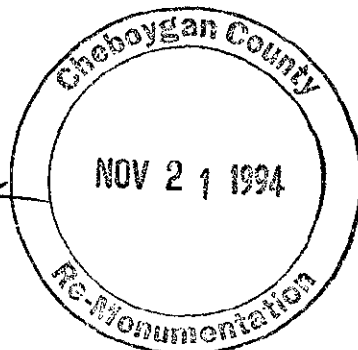


C. Description of monument for corner and accessories established to perpetuate locating the position of the corner:

PP N32°W 57.00'
PP N32°E 66.69'
PP S31°E 47.36'
fence cor. S05°W 36.95'

5/8" rebar w/ aluminum cap in Monument Box

LIBER 010 PAGE 55

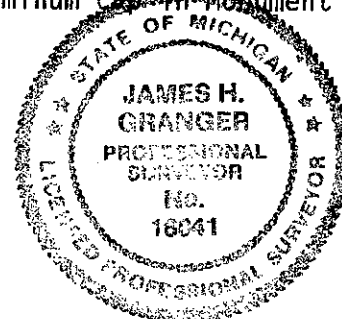

Signed by James H. Granger

Date 11-18-94

Surveyor's Michigan License No. 16041