

## CHEBOYGAN COUNTY REMONUMENTATION CORNER

LAND CORNER RECORDATION CERTIFICATE  
Filing Requirement of Act 74, Mich. P.A. 1970

For corners in

CHEBOYGAN  
(County)

Located In:

Corner Code #

## 1. Public Land Survey

38N 2W  
T 37NR 2WD-13  
B-12. Property Controlling  
in Section

S T R

3. Miscellaneous  
Property in Sec.

S T R

4. Lot No. \_\_\_\_\_, Recorded Plat \_\_\_\_\_  
5. Private Claims \_\_\_\_\_RECEIVED FOR RECORD 12-18-97  
at 11:43 O'Clock A M

Joanne Spray

CLERK/REGISTER  
CHEBOYGAN COUNTY, MICHIGAN

Register of Deeds Stamp &amp; File Number

I, JAMES H. GRANGER, in a field survey on JULY 15, 19 97 do hereby state that under requirements of P.A. 74, Michigan P.A. of 1970, the corner points mentioned in lines 1 and 2 above were in conformance with regulations and rules therefore as required in the current manual of survey instructions of the United States Department of the Interior, Bureau of Land Management or by a decree of a Court of Law and for that the corner points mentioned in lines 3, 4 and 5 above were in conformance with the rules of the Michigan Board of Land Surveyors or by a Decree of a Court of Law; established, re-established, monumented, recovered, found as expressed below:

NOTE: Not more than 2 corners, all in the same town and range, may be recorded on this certificate.

## A. Description of original monument and accessories and/or subsequent restoration:


D-1 1840 Original Survey Set wood post 16" Cedar N43°W 19 lks  
John Mullett 8" Birch N51°E 50 lks

SURVEY &  
REMONUMENTATION

FEB 26 1998

## SECTION

1	A	B	C	D	E	F	G	H	I	J	K	L	M
2		5		5		4		3		2		1	
3													
4		7		8		9		10		11		12	
5													
6		18		17		16		15		14		13	
7													
8		19		20		21		22		23		24	
9													
10		30		29		28		27		26		25	
11													
12		31		32		33		34		35			
13													

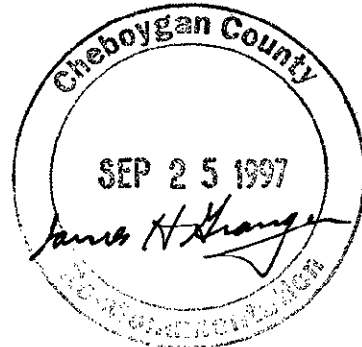


## B. Description of corner evidence found and/or method applied in restoring or reestablishing corner:

D-1 Found 1/2" iron with cap #12020 at corner position. Replaced with 5/8" rebar and remonumentation cap.

## C. Description of monument for corner and accessories established to perpetuate locating the position of the corner:

D-1 5/8" rebar and Remonumentation Cap  
8" Cedar S41°E 4.85' Set tag #16041  
8" Spruce N80°W 15.58' Set tag #16041  
8" Cedar N20°W 11.11' Set tag #16041  
8" Cedar N31°E 17.84' Set tag #16041

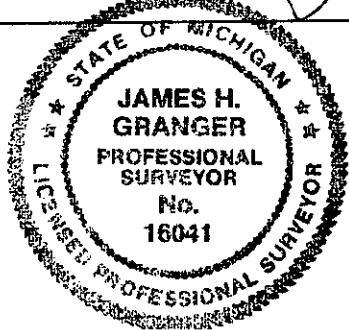Signed by \_\_\_\_\_  
License No. 16041Date Nov 17, 1997 Surveyor's MichiganFORM APPROVED BY MICHIGAN STATE BOARD OF PROFESSIONAL SURVEYORS, JAN. 28, 1971  
REVISED 14, 1975REVISED JAN., 1983  
REVISED OCT., 1996

LIBER 011 PAGE 47