

MAR 22 1999

LAND CORNER RECORDATION CERTIFICATE
Filing Requirement of Act 74, Mich. P.A. 1970

For corners in

CHEBOYGAN SECTION Located in:
(County)

Corner Code #

1. Public Land Survey T 38NR 2W F-3
T R
T R
T R
T R
2. Property Controlling S T R
in Section S T R
3. Miscellaneous S T R
Property in Sec. S T R

4. Lot No. , Recorded Plat
5. Private Claims

I, JAMES H. GRANGER, in a field survey on JULY 15, 19 98 do hereby state that under requirements of P.A. 74, Michigan P.A. of 1970, the corner points mentioned in lines 1 and 2 above were in conformance with regulations and rules therefore as required in the current manual of survey instructions of the United States Department of the Interior, Bureau of Land Management or by a decree of a Court of Law and for that the corner points mentioned in lines 3, 4 and 5 above were in conformance with the rules of the Michigan Board of Land Surveyors or by a Decree of a Court of Law, established, re-established, monumented, recovered, found as expressed below:

NOTE: Not more than 2 corners, all in the same town and range, may be recorded on this certificate.

A. Description of original monument and accessories and/or subsequent restoration:

1856 Original Survey	Set wood post	10" Pine	S31°E	9 lks
Harvey Mellen		12" Pine	N38°E	41 lks
1980 Survey	1" pipe			
Orlando Doyle #7319				
1982 LCRC	1" pipe			
Orlando Doyle #7319				
1986 Survey	Set ½" x 18" iron w/cap			
Robert Mitchell #28417				
1987 Plat	Indicates corner position			
Royal Grant #1				
1988 Survey	Found ½" iron w/cap #28417			
James H. Granger #16041				
1988 LCRC	½" iron w/cap #28417			
James H. Granger				
1990 LCRC	1" pipe			
Norman Quaine #33984				
1992 Survey	Found ½" iron w/cap #28417			
James H. Granger #16041				

B. Description of corner evidence found and/or method applied in restoring or reestablishing corner:

Found ½" iron with cap #28417 and 4 witnesses consistent with existing monumentation from Plat of Royal Grant #1.

C. Description of monument for corner and accessories established to perpetuate locating the position of the corner:



Removed ½" iron and set 5/8" rebar and Remonumentation Cap			
24" Pine	S74°W	23.71'	Fd. Nail and washer
8" Pine	S20°W	36.36'	Fd. Nail and washer
8" Pine	S60°E	25.33'	Fd. Nail and washer
4" Concrete Monument	S84°W	11.04'	Fd. Nail and washer

RECEIVED FOR RECORD 12-7-98
at 9:15 O'Clock A M

Joanne Spray

CLERK/REGISTER
CHEBOYGAN COUNTY, MICHIGAN
Register of Deeds Stamp & File Number

	A	B	C	D	E	F	G	H	I	J	K	L	M
1													
2	6		5			4		3		2		1	
3													
4	7		8			9		10		11		12	
5													
6	18		17			16		15		14		13	
7													
8	19		20			21		22		23		24	
9													
10	30		29			28		27		26		25	
11													
12	31		32			33		34		35		36	
13													

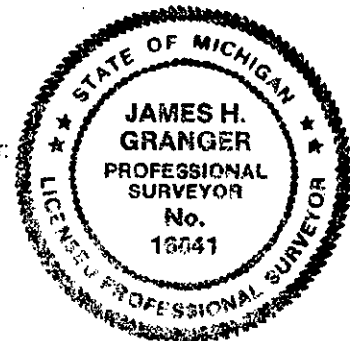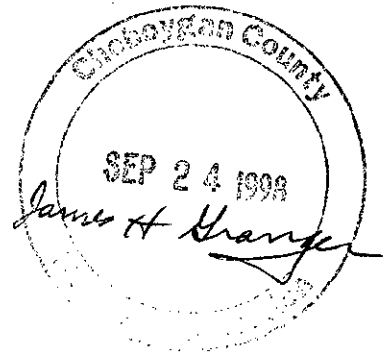

Signed by James H. Granger
License No. 16041

Date November 2, 1998 Surveyor's Michigan