

MAR 11 1999

SECTION

CHEBOYGAN COUNTY
REMONUMENTATION CORNER

LAND CORNER RECORDATION CERTIFICATE
Filing Requirement of Act 74, Mich. P.A. 1970

For corners in

<u>CHEBOYGAN</u> (County)	Located In:	Corner Code #
1. Public Land Survey	<u>T 38N R 2W</u>	<u>J-7</u>
	<u>T</u> <u>R</u>	
	<u>T</u> <u>R</u>	
	<u>T</u> <u>R</u>	
2. Property Controlling in Section	<u>S</u> <u>T</u> <u>R</u>	
	<u>S</u> <u>T</u> <u>R</u>	
3. Miscellaneous Property in Sec.	<u>S</u> <u>T</u> <u>R</u>	
	<u>S</u> <u>T</u> <u>R</u>	

RECEIVED FOR RECORD 12-7-98
at 9:25 O'Clock A M

Joanne Spray

CLERK/REGISTER
CHEBOYGAN COUNTY, MICHIGAN

Register of Deeds Stamp & File Number

4. Lot No. _____, Recorded Plat _____
5. Private Claims _____

I, JAMES H. GRANGER, in a field survey on July 15, 19 98 do hereby state that under requirements of P.A. 74, Michigan P.A. of 1970, the corner points mentioned in lines 1 and 2 above were in conformance with regulations and rules therefore as required in the current manual of survey instructions of the United States Department of the Interior, Bureau of Land Management or by a decree of a Court of Law and/or that the corner points mentioned in lines 3, 4 and 5 above were in conformance with the rules of the Michigan Board of Land Surveyors or by a Decree of a Court of Law; established, re-established, monumented, recovered, found as expressed below:

NOTE: Not more than 2 corners, all in the same town and range, may be recorded on this certificate.

A. Description of original monument and accessories and/or subsequent restoration:

1856 Original survey Harvey Mellen 5" Cedar at corner 6" Cedar S42°W 6 lks 5" Birch N3°W 12 lks	1953 Survey Orlando Doyle #7319 axe 1958 Plat Joseph Doyle Corner position shown Beaugrand Estates
1951 Survey Orlando Doyle #7319 Fd 1" axle	1973 Survey Orlando Doyle #7319 Corner Shown

	A	B	C	D	E	F	G	H	I	J	K	L	M
1													
2	6		5		4		3		2		1		
3													
4	7		8		9		10		11		12		
5													
6	18		17		16		15		14		13		
7													
8	19		20		21		22		23		24		
9													
10	30		29		28		27		26		25		
11													
12	31		32		33		34		35		36		
13													




B. Description of corner evidence found and/or method applied in restoring or reestablishing corner:

Fd. Concrete monument per Plat of Beaugrand Estates.

C. Description of monument for corner and accessories established to perpetuate locating the position of the corner:

Set remonumentation cap on existing concrete monument

10" Ash	S54°W 64.57' set tag #16041
PP	S35°E 44.84' fd. nail & washer
14" Birch	S54°E 18.22' set tag #16041
6" Maple clump	N36°W 60.56' set tag #16041

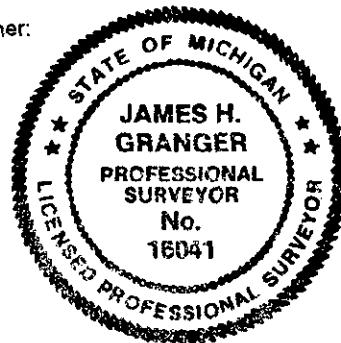

Signed by James H. Granger
Surveyor's Michigan License No. 16041

Date November 2, 1998