SURVEY & REMONUMENTATIONE REMONUMENTATION

RECEIVED FOR PECCRO

94 KOY 22 AM 10: 02

For	corners in	
Ch	eboygan	

Public Land Survey

5. Private Claims _


MAY 0 3 1995 LAND CORNER RECORDATION CERTIFICATE

COMM	Filing Requir NSSION	ement of Act 74, MICH. P.A. 19	Joannesd
	Located In:	Corner Code =##	•
	+ 38N p 2₩	K-12	CLERK/REGIS CHEBOYGAN COUNT

__ R _ _ R _ 2. Property Controlling in Section 3. Miscellaneous Property in Sec.

Register of Deeds Stamp & File Number

James H. Granger , in a field survey on	August	15	
do hereby certify that under requirements of P.A. 74, Mic	chigan P.A. o	f 1970, th	e corner points mentioned
in lines 1 and 2 above were in conformance with reg			
current manual of survey instructions of the United Sta			
Management or by a decree of a Court of Law and/or tha			
above were in conformance with the rules of the Michig	an Board of	Land Su-	rveyors or by a Decree of a
Court of Law; established, re-established, monume expressed below:	ented, re-mo	onument	ed, recovered, found as

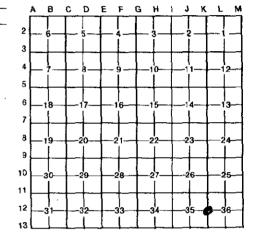

NOTE: Not more than 4 corners, all in the same town and range, may be recorded on this certificate.

A. Description of original monument and accessories and/or subsequent restoration:


12"pine N55°W 15 lks., 12"cedar S88°E 271ks. 1856 Original Survey Set Wood Post Harvey Mellen

1963 Ken Larsen #10695 fd 3/4"bolt 1966 Orlando Doyle #7319 fd metal mon. 1970 Orlando Doyle #7319 fd metal mon. 1974 Orlando Doyle #7319 fd metal mon. 1994 James Granger #16041 fd 1"pipe

____ , Recorded Plat _

3. Description of corner evidence found and/or method applied in restoring or reestablishing corner:

Found 1"pipe and 1 witness. Reset 5/8" rebar w/aluminim cap in Monument Box.

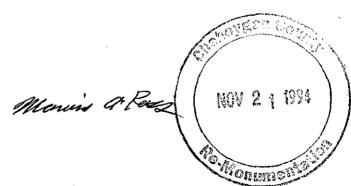


Description of monument for corner and accessories established to perpetuate locating the position of the corner:

5/8" rebar w/aluminim cap in Monument Box

N 59°W ₽P 69.30' 10"Pine N 9°W 40.72' 10"Pine S 14°E 50.26 S 62°W ₽Þ 73.64'

LIBER 010 PAGE 60

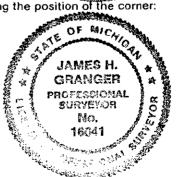

gned by _	James	H	Langer
-	Michigan Licens	e No	16041

__ Date ..