

SURVEY & REMONUMENTATION

MAY 03 1995

CHEBOYGAN COUNTY REMONUMENTATION

RECEIVED FOR RECORD

COMMISSION

LAND CORNER RECORDATION CERTIFICATE

NOV 22 AM 10:03

Filing Requirement of Act 74, Mich. P.A. 1970

For corners in

Cheboygan

(County)

Located In:

Corner Code #

1. Public Land Survey

T 38N R 2W

L-13

T R

T R

T R

2. Property Controlling in Section

S T R

S T R

3. Miscellaneous

S T R

Property in Sec.

S T R

4. Lot No. , Recorded Plat

5. Private Claims

CLERK/REGISTER
CHEBOYGAN COUNTY, MICHIGAN

Register of Deeds Stamp & File Number

I, James H. Granger, in a field survey on August 15, 1994

do hereby certify that under requirements of P.A. 74, Michigan P.A. of 1970, the corner points mentioned in lines 1 and 2 above were in conformance with regulations and rules therefore as required in the current manual of survey instructions of the United States Department of the Interior, Bureau of Land Management or by a decree of a Court of Law and/or that the corner points mentioned in lines 3, 4 and 5 above were in conformance with the rules of the Michigan Board of Land Surveyors or by a Decree of a Court of Law; established, re-established, monumented, re-monumented, recovered, found as expressed below:

NOTE: Not more than 4 corners, all in the same town and range, may be recorded on this certificate.

A. Description of original monument and accessories and/or subsequent restoration:

1840 Original Survey Set Wood Post 10"fir N47°E 121ks., 8"sugar N20°W 151ks.
John Mullett

1977 John Nelson #21273 fd 1/2"rod in Mon. Box
1992 Mark Ennes #25842 fd 1/2"rod in Mon. Box

B. Description of corner evidence found and/or method applied in restoring or reestablishing corner:



Found 1/2"rod in Monument Box. Reset 5/8" rebar w/aluminum cap in Monument Box

C. Description of monument for corner and accessories established to perpetuate locating the position of the corner:

5/8" rebar w/aluminum cap in Monument Box

PP N 00°E 32.48'
nail in top S 00°W 18.11'
of guardrail post
18"pine N 66°E 95.64'
nail in top of S 60°E 47.20'
guardrail post
nail in top of S 70°W 41.84'
guardrail post

LIGER 010 PAGE 61

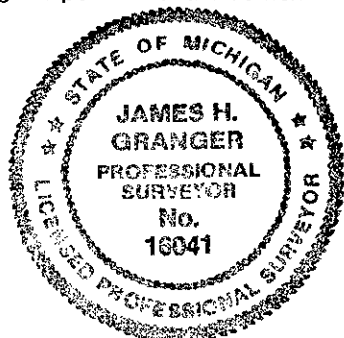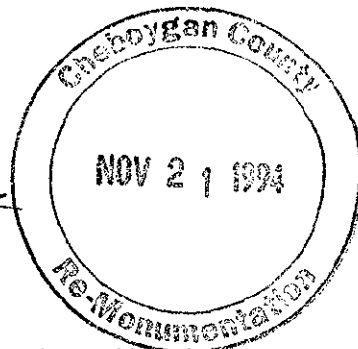

igned by James H. Granger

Date 11-18-94

urveyor's Michigan License No. 16041