

LAND CORNER RECORDATION CERTIFICATE
Filing Requirement of Act 74, Mich. P.A. 1970

MAR 22 1999

For corners in

CHEBOYGAN SECTION
(County)

Located In:

Corner Code #

1. Public Land Survey

T R
T R
T R
T R

2. Property Controlling
in Section

S 4 T38N R2W 2

3. Miscellaneous
Property in Sec.

S T R
S T R

4. Lot No. , Recorded Plat

5. Private Claims

I, JAMES H. GRANGER, in a field survey on July 15, 19 98 do hereby state that under requirements of P.A. 74, Michigan P.A. of 1970, the corner points mentioned in lines 1 and 2 above were in conformance with regulations and rules therefore as required in the current manual of survey instructions of the United States Department of the Interior, Bureau of Land Management or by a decree of a Court of Law and /or that the corner points mentioned in lines 3, 4 and 5 above were in conformance with the rules of the Michigan Board of Land Surveyors or by a Decree of a Court of Law; established, re-established, monumented, recovered, found as expressed below:

NOTE: Not more than 2 corners, all in the same town and range, may be recorded on this certificate.

A. Description of original monument and accessories and/or subsequent restoration:

1856 Original Survey
Harvey Mellen

Set Wood Post

8" Pine S78°E 83 lks
10" Pine S50°E 62 lks


RECEIVED FOR RECORD 12-7-98
at 9:11 O'Clock A M

Joanne Spray

CLERK/REGISTER
CHEBOYGAN COUNTY, MICHIGAN


Register of Deeds Stamp & File Number

	A	B	C	D	E	F	G	H	I	J	K	L	M
1													
2	6			5		4		3		2		1	
3													
4	7			8		9		10		11		12	
5													
6	13			17		16		15		14		13	
7													
8	19			20		21		22		23		24	
9													
10	30			29		28		27		26		25	
11													
12	31			32		33		34		35		36	
13													

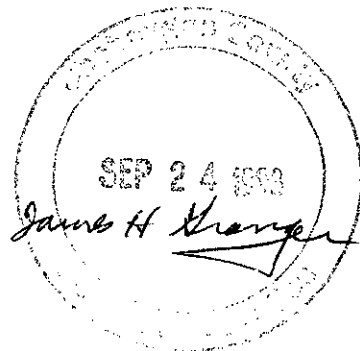

B. Description of corner evidence found and/or method applied in restoring or reestablishing corner:

No evidence found. Established witness position on extension of West line Section 9 North to shore.

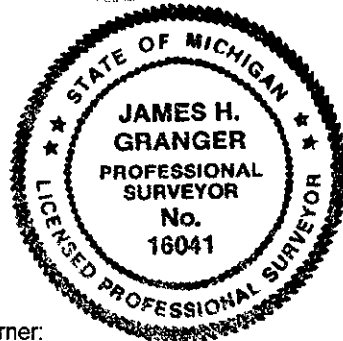

C. Description of monument for corner and accessories established to perpetuate locating the position of the corner:

5/8" rebar and remonumentation cap
10" Birch S32°E 14.49' Set tag #16041
10" Birch N56°W 11.51' Set tag #16041
Twin 20" Birch S64°W 18.14' Set tag #16041
10" White Pine S 8°W 38.20' Set tag #16041
Original Meander Corner 313.6 ft. on West Section line extension

Signed by James H. Granger
License No. 16041

Date November 2, 1998 Surveyor's Michigan