

MAR 22 1999

LAND CORNER RECORDATION CERTIFICATE
Filing Requirement of Act 74, Mich. P.A. 1970

For corners in

SECTION

CHEBOYGAN

(County)

Located in:

Corner Code #

1. Public Land Survey

T R

T R

T R

T R

2. Property Controlling
in Section

S 9

T38N R2W

3

S

T R

3. Miscellaneous

S

T R

Property in Sec.

S

T R

4. Lot No. , Recorded Plat

5. Private Claims

I, JAMES H. GRANGER, in a field survey on JULY 15, 19 98 do hereby state that under requirements of P.A. 74, Michigan P.A. of 1970, the corner points mentioned in lines 1 and 2 above were in conformance with regulations and rules therefore as required in the current manual of survey instructions of the United States Department of the Interior, Bureau of Land Management or by a decree of a Court of Law and for that the corner points mentioned in lines 3, 4 and 5 above were in conformance with the rules of the Michigan Board of Land Surveyors or by a Decree of a Court of Law; established, re-established, monumented, recovered, found as expressed below:

NOTE: Not more than 2 corners, all in the same town and range, may be recorded on this certificate.

A. Description of original monument and accessories and/or subsequent restoration:

1856 Original Survey
Harvey Mellen

Set wood post

12" Tamarack S58°W 1.05 chs

B. Description of corner evidence found and/or method applied in restoring or reestablishing corner:

No evidence found. Established witness position on extension of W. Line Section 15 North from W 1/4 thru NW corner.

C. Description of monument for corner and accessories established to perpetuate locating the position of the corner:

5/8" rebar and Remonumentation Cap

8" Cedar North 4.64' Set tag #16041

12" Balsam N69°W 9.99' Set tag #16041

4" Cedar S32°E 6.36' Set tag #16041

3" Cedar S58°E 15.44' Set tag #16041

Original Meander Corner 3.25 ft. on West Section line extension

RECEIVED FOR RECORD 12-7-98
at 9:17 O'Clock 4 M


Joanne Spray

CLERK/REGISTER

CHEBOYGAN COUNTY, MICHIGAN

Register of Deeds Stamp & File Number

	A	B	C	D	E	F	G	H	I	J	K	L	M
1													
2	6		5		4		3		2		1		
3													
4	7		8		9		10		11		12		
5													
6	18		17		16		15		14		13		
7													
8	19		20		21		22		23		24		
9													
10	30		29		28		27		26		25		
11													
12	31		32		33		34		35		36		
13													

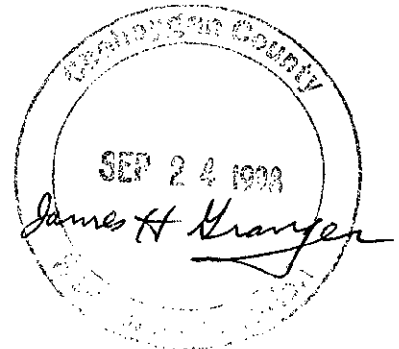

Signed by James H. Granger
License No. 16041

Date November 2, 1998

Surveyor's Michigan