

MAR 22 1999

LAND CORNER RECORDATION CERTIFICATE
Filing Requirement of Act 74, Mich. P.A. 1970

For corners in
SECTION
CHEBOYGAN
(County)

Located In:

Corner Code #

1. Public Land Survey

T R
T R
T R
T R

2. Property Controlling
in Section

S 15 T 38N R 2W 4

3. Miscellaneous
Property in Sec.

S T R
S T R

RECEIVED FOR RECORD 12-7-98
at 9:21 O'Clock 4 M

Joanne Spray

CLERK/REGISTER
CHEBOYGAN COUNTY, MICHIGAN

Register of Deeds Stamp & File Number


4. Lot No. , Recorded Plat
5. Private Claims

I, JAMES H. GRANGER, in a field survey on JULY 15, 19 98 do hereby state that under requirements of P.A. 74, Michigan P.A. of 1970, the corner points mentioned in lines 1 and 2 above were in conformance with regulations and rules therefore as required in the current manual of survey instructions of the United States Department of the Interior, Bureau of Land Management or by a decree of a Court of Law and /or that the corner points mentioned in lines 3, 4 and 5 above were in conformance with the rules of the Michigan Board of Land Surveyors or by a Decree of a Court of Law; established, re-established, monumented, recovered, found as expressed below:

NOTE: Not more than 2 corners, all in the same town and range, may be recorded on this certificate.

A. Description of original monument and accessories and/or subsequent restoration:

1856 Original Survey Set wood post 6" Tamarack N84°W 2.1 chs
Harvey Mellen 12" Cedar S19°E 17 lks

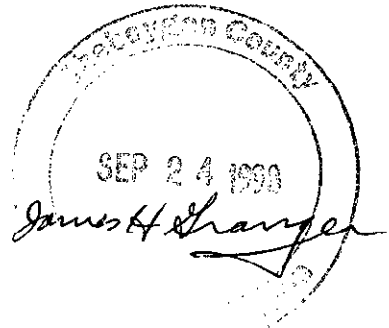

B. Description of corner evidence found and/or method applied in restoring or reestablishing corner:

No evidence found. Established witness position on extension of N. Line
Section 15 East to Lake.



C. Description of monument for corner and accessories established to perpetuate locating the position of the corner:

5/8" rebar and Remonumentation Cap
8" Cedar S39°W 7.04' Set tag #16041
8" Cedar N88°W 68.52' Set tag #16041
7" Cedar N10°E 12.85' Set tag #16041
3" Willow S62°E 10.00' Set tag #16041
Original Meander Corner position 18.32 ft. on North Section line extension

Signed by *James H. Granger*
License No. 16041

Date November 2, 1998 Surveyor's Michigan