

SURVEY &
REMONUMENTATION

CHEBOYGAN COUNTY
REMONUMENTATION CORNER

MAR 22 1999

LAND CORNER RECORDATION CERTIFICATE
Filing Requirement of Act 74, Mich. P.A. 1970

For corners in SECTION

CHEBOYGAN (County)	Located In:	Corner Code #
1. Public Land Survey	T___ R___	_____
	T___ R___	_____
	T___ R___	_____
	T___ R___	_____
2. Property Controlling in Section	S 6 T 38NR2W	6
	S___ T___ R___	_____
3. Miscellaneous Property in Sec.	S___ T___ R___	_____
	S___ T___ R___	_____

RECEIVED FOR RECORD 12-7-98
at 9:08 O'Clock A. M.

Joanne Spray

CLERK/REGISTER
CHEBOYGAN COUNTY, MICHIGAN
Register of Deeds Stamp & File Number

4. Lot No. _____, Recorded Plat _____
5. Private Claims _____

I, JAMES H. GRANGER, in a field survey on July 15, 1998, do hereby state that under requirements of P.A. 74, Michigan P.A. of 1970, the corner points mentioned in lines 1 and 2 above were in conformance with regulations and rules therefore as required in the current manual of survey instructions of the United States Department of the Interior, Bureau of Land Management or by a decree of a Court of Law and /or that the corner points mentioned in lines 3, 4 and 5 above were in conformance with the rules of the Michigan Board of Land Surveyors or by a Decree of a Court of Law; established, re-established, monumented, recovered, found as expressed below:

NOTE: Not more than 2 corners, all in the same town and range, may be recorded on this certificate.

A. Description of original monument and accessories and/or subsequent restoration:

1856 Original survey	Set Wood Post	14" Spruce S22°W 17 lks
		12" Cedar S22°E 39 lks
1930 Survey	Set Conc. Monument	
Gregory Shadko, P.E.		

B. Description of corner evidence found and/or method applied in restoring or reestablishing corner:


Found 1" axle. Axle fit well with existing concrete monuments in unrecorded Plat of Island View Shores. Existing monument is witness corner to GLO Meander Corner.

C. Description of monument for corner and accessories established to perpetuate locating the position of the corner:

Removed 1" axle and set 5/8" rebar and remonumentation cap

8" Cedar	N59°W	107.00'	Set tag #16041
14" Spruce	N78°W	95.97'	Set tag #16041
6" Cedar	S22°E	17.58'	Set tag #16041
14" Spruce	S19°W	51.14'	Set tag #16041

Original Meander Corner 106.56 ft. on E. Section line extension

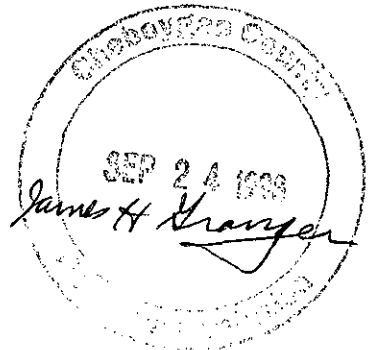

Signed by James H. Granger
Surveyor's Michigan License No. 16041

Date November 2, 1998