

*Granger*  
**SURVEY &  
REMONUMENTATION**  
MAY 03 1995

**CHEBOYGAN COUNTY REMONUMENTATION  
LAND CORNER RECORDATION CERTIFICATE**  
Filing Requirement of Act 74, Mich. P.A. 1970

RECEIVED  
FOR RECORD  
94 NOV 22 AM 9:40

For corners in **COMMISSION**

Cheboygan  
(County)

Located In:

Corner Code #

1. Public Land Survey

T 38N R 2W

M.C.

T R

8

T R

T R

2. Property Controlling  
in Section

S T R

S T R

3. Miscellaneous  
Property in Sec.

S T R

S T R

*James H. Granger*  
CLERK/REGISTER  
CHEBOYGAN COUNTY, MICHIGAN

Register of Deeds Stamp & File Number

4. Lot No. , Recorded Plat

5. Private Claims

I, James H. Granger, in a field survey on August 15, 19 94,  
do hereby certify that under requirements of P.A. 74, Michigan P.A. of 1970, the corner points mentioned  
in lines 1 and 2 above were in conformance with regulations and rules therefore as required in the  
current manual of survey instructions of the United States Department of the Interior, Bureau of Land  
Management or by a decree of a Court of Law and/or that the corner points mentioned in lines 3, 4 and 5  
above were in conformance with the rules of the Michigan Board of Land Surveyors or by a Decree of a  
Court of Law; established, re-established, monumented, re-monumented, recovered, found as  
expressed below:

**NOTE: Not more than 4 corners, all in the same town and range, may be recorded  
on this certificate.**

A. Description of original monument and accessories and/or subsequent restoration:


1856 Original Survey Set wood post, 12" Cedar S58°E 13 lks, 14" Cedar S40°W 28 lks.  
John Mullett  
1953 Orlando Doyle #7319 Set 1" Pipe  
1961 Orlando Doyle #7319 Plat Monument  
1990 Norman Quaine #33984 Fd 4" Conc Monument

B. Description of corner evidence found and/or method applied in restoring or reestablishing corner:

Fd conc. monument. Set 4 new witnesses.

	A	B	C	D	E	F	G	H	I	J	K	L	M
2	6	5	4	3	2	1							
3													
4	7	8	9	10	11	12							
5													
6	18	17	16	15	14	13							
7													
8	19	20	21	22	23	24							
9													
10	30	29	28	27	26	25							
11													
12	31	32	33	34	35	36							
13													


*Marvin A. Rose*

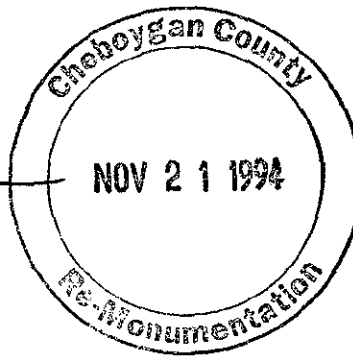

C. Description of monument for corner and accessories established to perpetuate locating the position of the corner:

Concrete Monument  
6" Spruce S10°E 47.96'  
12" Spruce S13°W 66.60'  
Twin 6" Spruce S71°W 82.36'  
8" Tamarack S88°W 55.62'

LIBER 010 PAGE 48

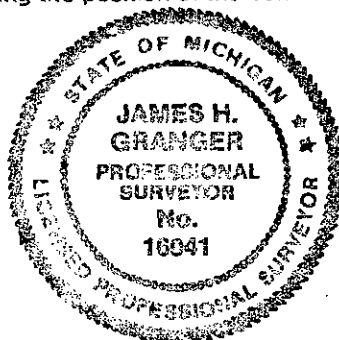

igned by James H. Granger

Date 11-18-94

urveyor's Michigan License No. 16041