

SURVEY &
REMONUMENTATION

CHEBOYGAN COUNTY REMONUMENTATION CORNER
LAND CORNER RECORDATION CERTIFICATE
Filing Requirement of Act 74, Mich. P.A. 1970

MAY 05 1997

For corners in
CHEBOYGAN

COMMISSION

Located In:

Corner Code #

(County)

Public Land Survey

T. 38N R. 3W

M-7

Property Controlling
in Section

S. T. R.

Miscellaneous
Property in Sec.

S. T. R.

RECEIVED
FOR RECORD

96 OCT 30 PM 12:14

Joanne Spray

CLERK/REGISTER
CHEBOYGAN COUNTY, MICHIGAN

Register of Deeds Stamp & File Number

Lot No. , Recorded Plat

Private Claims

JAMES H. GRANGER, in a field survey on OCTOBER 18, 1996
do hereby state that under requirements of P.A. 74, Michigan P.A. of 1970, the corner points
mentioned in lines 1 and 2 above were in conformance with regulations and rules therefore as
required in the current manual of survey instructions of the United States Department of the Interior,
Bureau of Land Management or by a decree of a Court of Law and /or that the corner points
mentioned in lines 3, 4 and 5 above were in conformance with the rules of the Michigan Board of
Land Surveyors or by a Decree of a Court of Law; established, re-established, monumented,
covered, found as expressed below:

NOTE: Not more than 2 corners, all in the same town and range, may be recorded
on this certificate.

	A	B	C	D	E	F	G	H	I	J	K	L	M
1													
2	6	5	4	3	2	1							
3													
4	7	8	9	10	11	12							
5													
6	18	17	16	15	14	13							
7													
8	19	20	21	22	23	24							
9													
10	30	29	28	27	26	25							
11													
12	31	32	33	34	35	36							
13													


Description of original monument and accessories and/or subsequent restoration:

#40 - Original Survey Set wood post 14" Cedar S36°E 14 lks
John Mullett 12" Cedar N31°W 19 lks
#34 - DNR-LCRC Set 1" pipe w/4" brass cap
Ken Larsen #10695

Description of corner evidence found and/or method applied in restoring or reestablishing corner:

1" pipe with 4" brass cap, 2 scribed witnesses and a 4' squared post.

Monica R. Ray

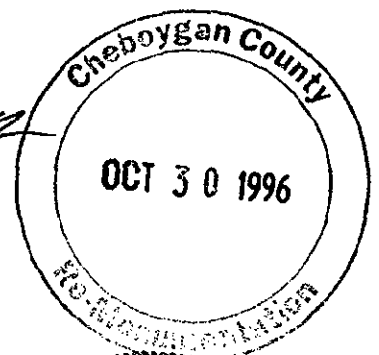


LIBER 010 PAGE 174

Description of monument for corner and accessories established to perpetuate locating the position of the corner
also corner A-7, T38N, R2W

ipe

Cedar	S 66°E	11.29'
Poplar	S45°W	27.22'
Arch	N85°W	10.23'
alsam	N12°E	16.91'

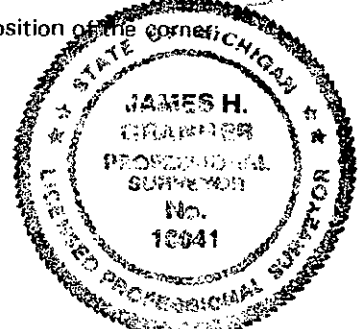

ed by *James H. Granger*
Surveyor's Michigan License No. 16041

Date 10-18-96