

MICHIGAN  
DEPARTMENT OF CONSERVATION  
FORESTRY DIVISION

# LAND CORNER RECORD

T. 38 N.R. 3 W.


Cheboygan COUNTY

DESCRIPTION OF CORNER Section corner common to Sections 1 - 2 - 11 - 12

CORNER MONUMENT Left large stone in place at corner

DATE MONUMENT PLACED AND WITNESSED April 17, 1963

WITNESSES TO CORNER.....

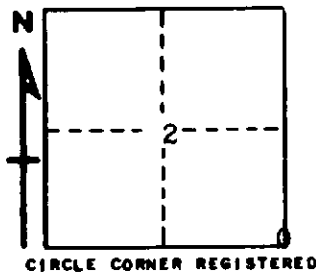

10" Tamarack S 48 W 43.6'

7" Tamarack S 77 E 25.4'

AND

DESCRIPTION IN DETAIL AS TO HOW CORNER WAS LOCATED AND IDENTIFIED OR RESTORED.

This corner was found while making a survey in this area. Found large stone buried at corner beneath road surface, at intersection of roads N - S - W. Located from witnesses of record and perpetuated to control surveys to east. Old and accepted corner.

SURVEYOR'S SEAL

SIGNED Kenneth Osting DATE April 24, 1963  
REGISTERED LAND SURVEYOR # 10068