

FEB 02 1999

SECTION

LAND CORNER RECORDATION CERTIFICATE

Filing Requirement of Act 74, Mich. P.A. 1970

Approved By Delta County  
Land Survey Remonumentation  
Peer Group Under Act 345 Of  
P.A. Of 1990 On October 30, 1998  
Robert Schmeling  
Chairman

For corners in  
DELTA  
(County)

Located In:

Corner Code #

1. Public Land Survey

T 40 N R 19 W

MC H/I-5 (18)

T 40 N R 19 W

MC H/I-7 (17) ✓

T R

T R

2. Property Controlling  
In Section

S T R

3. Miscellaneous  
Property in Sec.

S T R

Recorded Jan 4 1999  
3:40 PM  
Page 9  
Wallace C. Thuman  
County Clerk of Delta

Register of Deeds Stamp & File Number

4. Lot No. , Recorded Plat

5. Private Claims H/I-5 [MC SEC'S 10/15] H/I-7 [MC SEC'S 15/22]

I, M.P. DAVIS, in a field survey on DECEMBER, 19 98,  
do hereby certify that under requirements of P.A. 74, Michigan P.A. of 1970, the corner points mentioned  
in lines 1 and 2 above were in conformance with regulations and rules therefore as required in the  
current manual of survey instructions of the United States Department of the Interior, Bureau of Land  
Management or by a decree of a Court of Law and/or that the corner points mentioned in lines 3, 4 and 5  
above were in conformance with the rules of the Michigan Board of Land Surveyors or by a Decree of a  
Court of Law; established, re-established, monumented, re-monumented, recovered, found as  
expressed below:

NOTE: Not more than 4 corners, all in the same town and range, may be recorded  
on this certificate.

A. Description of original monument and accessories and/or subsequent restoration:  
H/I-5 [MC SEC'S 10/15] A.MERRYWEATHER - 1848 - WOOD POST - W.ASH 08' S60°W 21 LINKS  
NO RECORD EVIDENCE OF SUBSEQUENT CORNER RECOVERY AND/OR MONUMENTATION.

H/I-7 [MC SEC'S 15/22] A.MERRYWEATHER - 1848 - WOOD POST - ELM 20' S59°W 74 LINKS  
NO RECORD EVIDENCE OF SUBSEQUENT CORNER RECOVERY AND/OR MONUMENTATION

B. Description of corner evidence found and/or method applied in restoring or reestablishing corner:  
H/I-5 [MC SEC'S 10/15] NO CORNER EVIDENCE FOUND. ~~FD~~ IN PLACE AT E1/16 COR SEC'S 10/15 A 1" IRON PIN  
12" BELOW GRADE ON THE W. SHOULDER OF C.R.495. THIS COR WAS REFERENCED TO AS "E1/8 STK IN PLACE"  
IN 1914 BY M.S.MCNABB IN HIS ALIGNMENT NOTES FOR C.R.495. NO BT'S NOTED OR DESCRIPTION OF MONU-  
MENT GIVEN IN HIS NOTES. WM. BOWMAN, RLS, RECOVERED 1" IRON BAR AS REFERENCED TO IN HIS PLAT OF  
SURVEY REC'D LIBER 327 PAGE 233. EXTENDED LINE EAST FROM 1/4 COR SEC'S 10/15 THRU THE FOUND E1/16  
CORNER AND ESTABLISHED THE MC ON THIS LINE AND AT "GLO" DISTANCE (2145') EAST OF THE 1/4 COR SEC'S  
10/15 WHICH FITS WELL WITH THE PRESENT SHORE LINE.

H/I-7 [MC SEC'S 15/ 22] NO CORNER EVIDENCE FOUND. EXTENDED LINE EAST FROM NW CORNER OF SEC 22 THRU  
THE N1/4 COR OF SEC 22 AND SET A REFERENCE MONUMENT ON THIS LINE 100.0' SHORT OF THE "GLO"  
FROM THE 1/4 COR TO THE MC. THE "GLO" DISTANCE EAST OF THE 1/4 CORNER NOW FALLS WELL INTO  
LITTLE BAY DE NOC.

C. Description of monument for corner and accessories established to perpetuate locating the position of the corner:

H/I-5 SET A BERNTSEN A1NB30 ALUMN MON W/A 3 1/4" ALUMN CAP STAMPED TO ID THE CORNER POSITION.

ASH 06"	ASH 04"	X ON LARGE STONE	SURVEY MONUMENT SIGN POST
N22°E	S83°W	EAST	EAST
53.02'	44.20'	87.60'	1.54' (TO FACE)


H/I-7 (REFERENCE MONUMENT) SET A BERNTSEN A1NB30 ALUMN MON W/A 3 1/4" ALUMN CAP STAMPED TO ID THE CORNER POSITION.

ASH 08"	ASH 08"	TWIN ASH 08"	SURVEY MONUMENT SIGN POST
N02°E	S12°E	N75°W	EAST
37.61'	29.72'	12.48'	1.17' (TO FACE)

NOTE: BEARINGS TO REFERENCE OBJECTS ARE MAGNETIC-DISTANCES ARE TO A NAIL W/A DELTA COUNTY REFERENCE TAG, UNLESS OTHERWISE NOTED.

Signed by M.P. Davis Date 12/23/98

Surveyor's Michigan License No. 16926

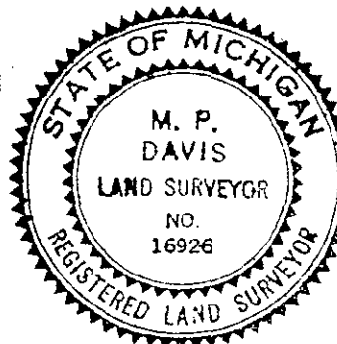

ALPHA 4