

SURVEY & REMONUMENTATION

FEB 18 1994

COMMISSION

LAND CORNER RECORDATION CERTIFICATE Filing Requirement of Act 74, Mich. P.A. 1970

Approved By Delta County
Land Survey Remonumentation
Peer Group Under Act 345 Of
P.A. Of 1990 On Jan 20, 1994
Robert Schumaker
Acting Chairman

For corners in

DELTA

(County)

Located In:

Corner Code #

1. Public Land Survey

T 40 N R 22 W

D-9 & E-6

T R

T R

T R

2. Property Controlling
in Section

S T R

S T R

3. Miscellaneous
Property in Sec.

S T R

S T R

Recorded January 21, 1994

at 9:00 o'clock a.m. in Liber 7 Page 360

William C. Thum Reg. of Deeds.
Delta County, Michigan

Register of Deeds Stamp & File Number

4. Lot No. , Recorded Plat

5. Private Claims

[D-9] N1/4 COR SEC 29 [E-6] W1/4 COR SEC 16

I, M.P. DAVIS, in a field survey on NOVEMBER, 19 93,
do hereby certify that under requirements of P.A. 74, Michigan P.A. of 1970, the corner points mentioned
in lines 1 and 2 above were in conformance with regulations and rules therefore as required in the
current manual of survey instructions of the United States Department of the Interior, Bureau of Land
Management or by a decree of a Court of Law and/or that the corner points mentioned in lines 3, 4 and 5
above were in conformance with the rules of the Michigan Board of Land Surveyors or by a Decree of a
Court of Law; established, re-established, monumented, re-monumented, recovered, found as
expressed below:

**NOTE: Not more than 4 corners, all in the same town and range, may be recorded
on this certificate.**

A. Description of original monument and accessories and/or subsequent restoration:


D-9 [N1/4 COR SEC 29] WOOD POST - A. MERRYWEATHER, D.S. - 1846 (NORWAY PINE 20'-N42'E-30 LINKS) (WHITE PINE 20'-S52'W -29 LINKS)
JAMES M. BARKER, SURVEYOR - 1887 - REFERENCE PLAT OF SOUTH GLADSTONE LIBER "A" OF PLATS PAGE 15 - NOT WITS NOTED.
D.A. BROTHERRON - 1895 - ID CORNER POSITION FROM BURNT STUMPS OF BOTH ORIGINALS - NEW BT'S (TELE POLE S52'E-21.6) (IRON HUB-
S24'E-44.6')
N.S. McNABB - 1931 - ID COR POSITION FROM WOOD STAKE & PLAT OF SOUTH GLADSTONE - SET 1P IN CONC MON - NEW BT'S (OAK 10'-N63'W-
79.8') (OAK 10'-N5'E-37')

E-6 [W1/4 COR SEC 16] WOOD POST-WOOD POST - A. MERRYWEATHER, D.S. - 1846 (W. PINE 28'-N66'E-49 LINKS) (NORWAY PINE 26'-S45'W-1.37 CHS
N.S. McNABB - 1925 - IRON STAKE IN PLACE - NO WIT'S OR DESCRIPTION OF THE ORIGIN OF THE MON FOUND MENTIONED IN McNABB'S NOTES
GEORGE NAULT-RLS 6521 [FOR M.D.O.T.] - 1971-FOUND AXEL SHAFT IN PLACE-NEW BT'S (CHERRY 14'-N40'E-35.7') (OAK 12'-S80'E-24.07')

B. Description of corner evidence found and/or method applied in restoring or reestablishing corner:

D-9 [N1/4 COR SEC 29] FOUND THIS DATE McNABB'S CONC MON - ID COR POSITION FROM PLAT OF
NASHEK-BUCKBEE ADDITION TO GLADSTONE-REC'D LIBER "B" OF PLAT PAGE 57 - ACCEPTED EXISTING
MONUMENT AS BEING A CAREFUL & FAITHFUL PERPETUATION OF THE POSITION OF THE ORIGINAL CORNER.

E-6 [W1/4 COR SEC 16] FOUND THIS DATE AXEL SHAFT AS DESCRIBED IN M.D.O.T. RECORDS - ACCEPTED
EXISTING MONUMENT AS A CAREFUL & FAITHFUL REESTABLISHMENT OF THE POSITION OF THE
ORIGINAL CORNER.

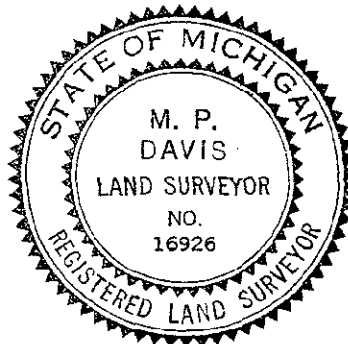

C. Description of monument for corner and accessories established to perpetuate locating the position of the corner:

D-9 SET, OVER EXISTING MON, A 5/8" X 18" REBAR W/A 3-1/4" ALUMN CAP STAMPED TO ID COR POSITION & RAISED TO RD SURFACE W/A MON BOX
OAK 26" POWER POLE OAK 15" JACK PINE 7"
N12'W N73'E S48'E S18'W
75.42' 81.62' 101.85 58.20'

E-6 SET, OVER EXISTING MON, A BERNTSEN AINE30 ALUMN MON W/A CAP STAMPED TO ID THE COR POSITION
OAK 12' JACK PINE 13" CONC. MON. SURVEY MONUMENT SIGN POST
N32'E S17'E EAST WEST
66.97' 65.38' 33.0' 2.98' (TO FACE)

NOTE: BEARINGS TO REFERENCE OBJECTS ARE MAGNETIC & DISTANCES ARE TO A NAIL IN THE CENTER OF THE OBJECT UNLESS OTHERWISE NOTED

Signed by M.P. Davis Date 11/15/93

Surveyor's Michigan License No. 16926