

SURVEY & REMONUMENTATION

OCT 03 2000

SECTION

LAND CORNER RECORDATION CERTIFICATE

Filing Requirement of Act 74, Mich. P.A. 1970

Approved By Delta County
Land Survey Remonumentation
Peer Group Under Act 345 of

P.A. of 1990 On July 12, 2000

John C. Ziem
Chairman

For corners in

DELTA
(County)

Located In:

Corner Code #

1. Public Land Survey

T ₄₀ N R ₂₃ W	K-03
T ₄₀ N R ₂₃ W	K-06
T R	
T R	
2. Property Controlling in Section

S

T R

3. Miscellaneous Property in Sec.

S

T R

S

T R

RECORDED 28 July 2000

AT 9:00 O'CLOCK a.m.

LIBER 9 PAGE 222

John C. Ziem
DELTA COUNTY MI REG. OF DEEDS

Register of Deeds Stamp & File Number

4. Lot No. , Recorded Plat
5. Private Claims

K-03 [NW COR SEC 12]

K-06 [W1/4 COR SEC 13]

I, M.P. DAVIS, in a field survey on MAY, 2000, do hereby state that under requirements of P.A. 74, Michigan P.A. of 1970, the corner points mentioned in lines 1 and 2 above were in conformance with regulations and rules therefore as required in the current manual of survey instructions of the United States Department of the Interior, Bureau of Land Management or by a decree of a Court of Law and /or that the corner points mentioned in lines 3, 4 and 5 above were in conformance with the rules of the Michigan Board of Land Surveyors or by a Decree of a Court of Law; established, re-established, monumented, recovered, found as expressed below:

NOTE: Not more than 2 corners, all in the same town and range, may be recorded on this certificate.

	A	B	C	D	E	F	G	H	I	J	K	L	M
1													
2	6		5		4		3		2		1		
3													
4	7		8		9		10		11		12		
5													
6	18		17		16		15		14		13		
7													
8	19		20		21		22		23		24		
9													
10	30		29		28		27		26		25		
11													
12	31		32		33		34		35		36		
13													

A. Description of original monument and accessories and/or subsequent restoration:


K-03 [NW COR SEC 12] A.MERRYWEATHER, D.S. - 1846 - SET POST - (BEECH 05" S60°E 07 LINKS) (CEDAR 10" NORTH 10 LINKS) D.A.BROTHERTON - 1895 - ORIGINALS IN PLACE NOTED NEW BT'S (Y.BIRCH 10" N13°W 66.3') (B.ASH 5" N59°W 42') M.S.McNABB - 1932 - FOUND IN PLACE FROM PREVIOUS SURVEYS - W.PINE 8" S18°E 60.0' - NO DESCRIPTION OF MONUMENT GIVEN M.DAVIS - 1973 - L.1 OF LCR'S PG 335 - FD IRON PIN IN PLACE (PP S8°E 43.6') (PP N80°E 74.9') (PP N66°W 114.3') M.DAVIS - 1976 - L.2 OF LCR'S PG 84 - ID MONUMENT AS MENTIONED ABOVE & AT THIS TIME HAD ACQUIRED THE RECORDS OF M.S.McNABB WHICH REFERENCED TO A W.PINE BT TO THE SE WHICH IS STILL GREEN & CHECKS WELL TO THE EXISTING MONUMENT.

K-06 [W1/4 COR SEC 13] A. MERRYWEATHER, D.S. 1846 - (HEMLOCK 14" S40°E 20 LINKS) (HEMLOCK 24" N11°W 45 LINKS) M.S.McNABB-1944 - STAKE IN PLACE - HEMLOCK 9" N42°E 66'

B. Description of corner evidence found and/or method applied in restoring or reestablishing corner:

K-03 [NW COR SEC 12] FOUND IN PLACE AND 24"± BELOW THE ROAD SURFACE A 3/4" IRON PIN AS PREVIOUSLY RECOVERED. ID EXISTING MONUMENT FROM THE W.PINE BT TO THE SE WHICH IS STILL GREEN. ACCEPTED EXISTING MONUMENT AS BEING A CAREFUL & FAITHFULL PERPETUATION OF THE POSITION IF THE ORIGINAL CORNER.

K-06 [W1/4 COR SEC 13] NO CORNER EVIDENCE FOUND. REESTABLISHED CORNER POSITION ON LINE WITH AND AT THE MIDPOINT BETWEEN SECTION CORNERS 1/2 MILE NORTH AND SOUTH.

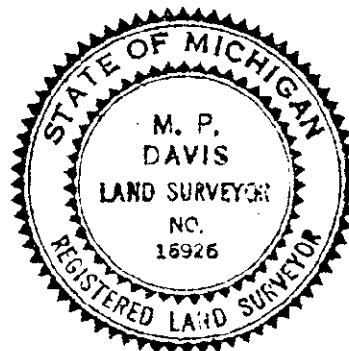

C. Description of monument for corner and accessories established to perpetuate locating the position of the corner:

K-03 PLACED, OVER EXISTING MON, A 5/8" X 18" REBAR W/A ALUM CAP STAMPED TO ID THE COR POSITION & RAISED TO GRADE WITH A MON BOX.
SURVEY MONUMENT SIGN POST
NORTH
23.36' (TO FACE)

CEDAR 09"	CEDAR 10"	W.PINE 24" (OLD BT)
N31°E	S70°W	S18°E
61.35'	86.58'	60.10'

K-06 SET A 5/8" X 18" REBAR W/A 3-1/4" ALUM CAP STAMPED TO ID THE CORNER POSITION & RAISED TO GRADE W/A MON BOX
SURVEY MONUMENT SIGN POST
N83°W
21.93' (TO FACE)

POWER POLE	5/8" X 18" REBARS W/A 2" ALUM DELTA COUNTY WITNESS CAP
S81°E	N45°W
27.75'	28.08'
	S45°W
	30.88'

NOTE: BEARINGS TO REFERENCE OBJECTS ARE MAGNETIC-DISTANCES ARE TO A NAIL W/A DELTA COUNTY REFERENCE TAG, UNLESS OTHERWISE NOTED.

Signed by M.P. Davis

Date 7/13/00

Surveyor's Michigan License No. 16926