

**SURVEY & REMONUMENTATION**

**OCT 03 2000**

**SECTION**

**LAND CORNER RECORDATION CERTIFICATE**  
Filing Requirement of Act 74, Mich. P.A. 1970

Approved By Delta County  
Land Survey Remonumentation  
Peer Group Under Act 345 of  
P.A. of 1990 On July 12, 2000  
Robert B. Shouling  
Acting Chairman

For corners in

DELTA (County)	Located In:	Corner Code #
1. Public Land Survey	T 40 N R 23 W	A-06 SAME
	T 40 N R 24 W	M-06 CORNER
	T 40 N R 23 W	A-07 SAME
	T 40 N R 24 W	M-07 CORNER
2. Property Controlling in Section	S ___ T ___ R ___	___
	S ___ T ___ R ___	___
	S ___ T ___ R ___	___
	S ___ T ___ R ___	___
3. Miscellaneous Property in Sec.	S ___ T ___ R ___	___
	S ___ T ___ R ___	___
	S ___ T ___ R ___	___
	S ___ T ___ R ___	___

RECORDED 28 July 2000

AT 9:00 O'CLOCK a.m.

LIBER 9 PAGE 237


William C. Thomas  
DELTA COUNTY MI REG. OF DEEDS

Register of Deeds Stamp & File Number

- 4. Lot No. \_\_\_\_\_ Recorded Plat \_\_\_\_\_
- 5. Private Claims \_\_\_\_\_

I, M.P. DAVIS, in a field survey on JANUARY, 2000 do hereby state that under requirements of P.A. 74, Michigan P.A. of 1970, the corner points mentioned in lines 1 and 2 above were in conformance with regulations and rules therefore as required in the current manual of survey instructions of the United States Department of the Interior, Bureau of Land Management or by a decree of a Court of Law and/or that the corner points mentioned in lines 3, 4 and 5 above were in conformance with the rules of the Michigan Board of Land Surveyors or by a Decree of a Court of Law, established, re-established, monumented, recovered, found as expressed below:

NOTE: Not more than 2 corners, all in the same town and range, may be recorded on this certificate.

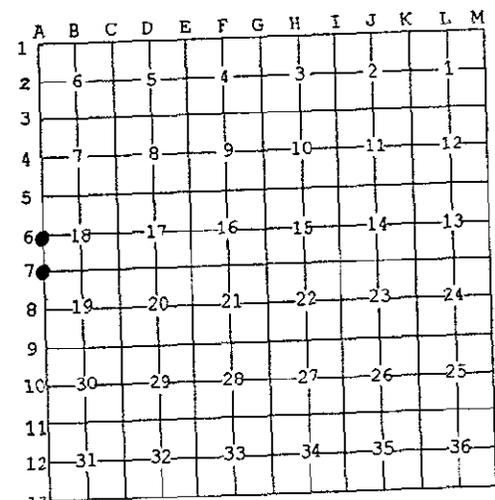

- A. Description of original monument and accessories and/or subsequent restoration:
- A-06 [W1/4 COR SEC 18] JOHN BURT, D.S. - 1845 - WOOD POST (HEMLOCK 12" S51°W 50 LINKS) (HEMLOCK 15" N14°W 24 LINKS) M.S. McNABB - 1936 - CORNER IN PLACE, NO DESCRIPTION OF MONUMENT - CEDAR STUMP SOUTH 31.7' CEDAR STUMP N25°E 20.8'
  - A-07 [NW COR SEC 19] JOHN BURT, D.S. - 1845 - WOOD POST (SPRUCE 06 S80°W 27 LINKS) (SPRUCE 06" N20°W 23 LINKS) A. MERRYWEATHER, D.S. 1846 - SPRUCE 11" N57°E 24 LINKS CEDAR 10" S20°E 12 LINKS M.S. McNABB - 1921 - ORIGINALS GONE, ESTABLISHED BETWEEN CORNERS NORTH & SOUTH (WHICH CORNERS NOT STATED IN HIS FIELD NOTES, M.D.) TAMARACK STUMP 9" NORTH 24.5' TAMARACK STUMP 8" S45°E 42.8'

- B. Description of corner evidence found and/or method applied in restoring or reestablishing corner:
- A-06 [W1/4 COR SEC 18] NO CORNER EVIDENCE FOUND, REESTABLISHED CORNER POSITION BY RETRACEMENT OF M.S. McNABB'S 1936 SURVEY OF THE EAST-WEST 1/4 LINE OF SEC. 13 T40N R24W. RECOVERED McNABB'S W1/4 & C1/4 CORNER POSITIONS OF SEC 13 T40N R24W AND EXTENDED A LINE EAST FROM THE W1/4 COR THRU THE C1/4 COR AND ESTABLISHED THE 1/4 CORNER ON THIS LINE AND AT A PROPORTIONATE DISTANCE EAST OF THE C1/4 COR BASED ON THE 1936 MEASUREMENTS OF McNABB. ACCEPTED AS BEING A CAREFUL & FAITHFUL REESTABLISHMENT OF THE POSITION OF THE ORIGINAL CORNER.
  - A-07 [NW COR SEC 19] NO CORNER EVIDENCE FOUND. REESTABLISHED THE CORNER POSITION BY RETRACEMENT OF M.S. McNABB'S 1921 SURVEY OF THE NORTH LINE OF SEC 19 T40N R23W. RECOVERED THE NE AND N1/4 CORNERS OF SEC 19 T40N R23W AND EXTENDED A LINE WEST FROM THE NE COR THRU THE N1/4 COR AND ESTABLISHED THE NW COR SEC 19 ON THIS LINE AND AT A PROPORTIONATE DISTANCE WEST OF THE N1/4 COR BASED ON THE 1921 MEASUREMENTS OF McNABB. ACCEPTED AS BEING A CAREFUL AND FAITHFUL REESTABLISHMENT OF THE POSITION OF THE ORIGINAL.



- C. Description of monument for corner and accessories established to perpetuate locating the position of the corner:
- A-06 SET, 6"± BELOW ROAD SURFACE, A 5/8" X 18" REBAR W/A 3-1/4" ALUM CAP STAMPED TO ID THE CORNER POSITION. TAMARACK 10" W. PINE 13" EAST GATE POST WEST GATE POST N23°W N68°E S07°E S34°W 79.90' 50.92' 20.08' 27.68'
  - A-07 SET A BERNTSEN A1NB30 ALUM MONUMENT WITH THE CAP STAMPED TO ID THE CORNER POSITION. CEDAR 07" CEDAR 12" CEDAR 11" CEDAR 06" SURVEY MONUMENT SIGN POST N40°W N31°E S68°E S67°W SOUTH 35.54' 29.08' 36.48' 22.80' 1.70' (TO FACE)

NOTE: BEARINGS TO REFERENCE OBJECTS ARE MAGNETIC-DISTANCES ARE TO A NAIL W/A DELTA COUNTY REFERENCE TAG, UNLESS OTHERWISE NOTED.

Signed by M.P. Davis  
Surveyor's Michigan License No. 16926

Date 7/13/00