

JAN 25 2000

SECTION

LAND CORNER RECORDATION CERTIFICATE  
Filing Requirement of Act 74, Mich. P.A. 1970

Approved By Delta County  
Land Survey Remonumentation  
Peer Group Under Act 345 Of  
P.A. Of 1990 On Dec 28, 1999

Robert Schumling  
Chairman

For corners in

DELTA (County)	Located In:	Corner Code #
1. Public Land Survey	T 43 N R 20 W T 44 N R 20 W T 43 N R 20 W T R S T R S T R S T R S T R	K-01 SAME K-13 CORNER K-02        

K-01 [NW COR SEC 1] K-02 [W1/4 COR SEC 1]

4. Lot No. \_\_\_\_\_, Recorded Plat \_\_\_\_\_  
5. Private Claims \_\_\_\_\_

I, M.P. DAVIS, in a field survey on DECEMBER, 1999 do hereby state that under requirements of P.A. 74, Michigan P.A. of 1970, the corner points mentioned in lines 1 and 2 above were in conformance with regulations and rules therefore as required in the current manual of survey instructions of the United States Department of the Interior, Bureau of Land Management or by a decree of a Court of Law and /or that the corner points mentioned in lines 3, 4 and 5 above were in conformance with the rules of the Michigan Board of Land Surveyors or by a Decree of a Court of Law; established, re-established, monumented, recovered, found as expressed below:

NOTE: Not more than 2 corners, all in the same town and range, may be recorded on this certificate.

01-04-00  
AT 2:00 O'CLOCK PM  
LIBER 9 PAGE 185  
William S. Brown  
REGISTERED

Register of Deeds Stamp & File Number


	A	B	C	D	E	F	G	H	I	J	K	L	M
1													
2	6		5		4		3		2				
3													
4	7		8		9		10		11				
5													
6	18		17		16		15		14				
7													
8	19		20		21		22		23				
9													
10	30		29		28		27		26				
11													
12	31		32		33		34		35				
13													

A. Description of original monument and accessories and/or subsequent restoration:

- K-01 [NW COR SEC 1] JOHN BURT, D.S.-1841-WOOD POST (W.PINE 12" S50°E 43 LINKS)(W.PINE 12" N67°E 20 LINKS):  
BAY DE NOC LUMBER COMPANY-DATE UNKNOWN-UNRECORDED PLAT OF STONER LAKE SHOWS CORNER IN PLACE-NO DESCRIPTION GIVEN.
- K-02 [W1/4 COR SEC 1] A.MERRYWESTHER, D.S. 1849-WOOD POST (BEECH 12" WEST 25 LINKS)(HEMLOCK 18" N80°E 42 LINKS)  
NO RECORD EVIDENCE OF CORNER RECOVERY AND/OR SUBSEQUENT MONUMENTATION.

B. Description of corner evidence found and/or method applied in restoring or reestablishing corner:

- K-01 [NW COR SEC 1] FROM PREVIOUS VISITS TO THE AREA FOUND A 3/4" IRON PIPE ON THE EAST SHORE OF STONER LAKE. WHEN I FIRST FOUND THIS MONUMENT IN 1971 IT WAS UNDER WATEWR. ID THE CORNER MONUMENT FROM RETRACEMENT OF PORTIONS OF THE UNRECORDED PLAT OF STONER LAKE. ACCEPTED THE EXISTING MONUMENT AS BEING THE BEST AVAILABLE EVIDENCE AS TO THE LOCATION OF THE POSITION OF THE ORIGINAL CORNER.
- K-02 [W1/4 COR SEC 1] NO CORNER EVIDENCE FOUND. REESTABLISHED CORNER POSITION ON LINE WITH AND PROPORTIONATE DISTANCE BETWEEN THE SECTION CORNERS 1/2 MILE TO THE NORTH AND SOUTH.

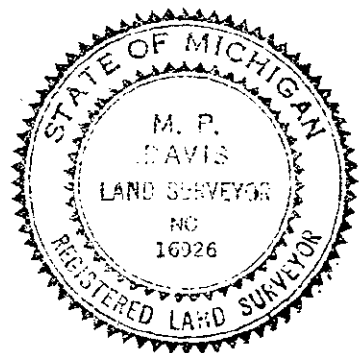

C. Description of monument for corner and accessories established to perpetuate locating the position of the corner:

- K-01 SET, INSIDE THE EXISTING MONUMENT, A 5/8" X 18" REBAR WITH A3-1/4" ALUM CAP STAMPED TO ID THE CORNER POSITION. L.  
W.PINE 20" W.PINE 18" W.PINE 18" SURVEY MONUMENT SIGN POST  
N20°E S48°E S22°E EAST  
70.60' 38.27' 48.27' 28.55'(TO FACE)
- K-02 SET A BERNTSEN A1NB30 ALUM MONUMENT WITH THE CAP STAMPED TO ID THE CORNER POSITION.  
MAPLE 10" MAPLE 12' MAPLE 09" MAPLE 07" SURVEY MONUMENT SIGN POST  
N03°W N63°E SOUTH S65°W WEST  
16.18' 7.05' 2.18' 29.96' 2.18'(TO FACE)

NOTE: BEARINGS TO REFERENCE OBJECTS ARE MAGNETIC-DISTANCES ARE TO A NAIL W/A DELTA COUNTY REFERENCE TAG, UNLESS OTHERWISE NOTED.

Signed by M.P. Davis  
Surveyor's Michigan License No. 16926

Date 12/20/99