

JAN 26 2000

SECTION

LAND CORNER RECORDATION CERTIFICATE  
Filing Requirement of Act 74, Mich. P.A. 1970

Approved By Delta County  
Land Survey Remonumentation  
Peer Group Under Act 345 Of  
P.A. Of 1990 On Dec 28, 1999

*John Schmeling*  
Chairman

For corners in

DELTA Located In: Corner Code #  
(County)

1. Public Land Survey T R  
T 43 N R 20 W MC M-1/2 SAME (20)  
T 43 N R 19 W MC A-1/2 CORNER (2)  
T 43 N R 20 W MC M-2/3 SAME (6)  
T 43 N R 19 W MC A-2/3 CORNER (2) ✓

2. Property Controlling S T R  
in Section S T R  
3. Miscellaneous S T R  
Property in Sec. S T R

01-04-00  
2:00 PM  
9 PAGE 194  
*John C. Thomas*

Register of Deeds Stamp & File Number

M-1/2 [MEANDER COR E.LINE SEC. 1-N. SHORE ROUND LAKE] M-2/3 [MEANDER COR. E.LINE SEC. 1-S.SHORE ROUND LAKE]  
4. Lot No. , Recorded Plat  
5. Private Claims

I, M.P. DAVIS, in a field survey on NOVEMBER, 19 99 do hereby state that under requirements of P.A. 74, Michigan P.A. of 1970, the corner points mentioned in lines 1 and 2 above were in conformance with regulations and rules therefore as required in the current manual of survey instructions of the United States Department of the Interior, Bureau of Land Management or by a decree of a Court of Law and /or that the corner points mentioned in lines 3, 4 and 5 above were in conformance with the rules of the Michigan Board of Land Surveyors or by a Decree of a Court of Law; established, re-established, monumented, recovered, found as expressed below:

NOTE: Not more than 2 corners, all in the same town and range, may be recorded on this certificate.

	A	B	C	D	E	F	G	H	I	J	K	L	M
1													
2	6		5		4		3		2		1		
3													
4	7		8		9		10		11		12		
5													
6	10		17		16		15		14		13		
7													
8	19		20		21		22		23		24		
9													
10	30		29		28		27		26		25		
11													
12	31		32		33		34		35		36		
13													

A. Description of original monument and accessories and/or subsequent restoration:


M-1/2 [MEANDER COR E. LINE SEC 1] Wm. BURT, D.S. - 1841 - W.BIRCH 8" CORNER TREE (Y.PINE 14" N35°W 15 LINKS)  
ROBERT E. SCHMELING-ESCANABA PAPER CO. - 1965 - L.4 OF LCR'S PG. 7 - REESTABLISHED MC AT RECORDED DISTANCE SOUTH OF THE 4 TOWN CORNER AND SET A 1" I.P. WITH A 3" BRASS CAP STAMPED TO ID THE CORNER POSITION. [W.PINE 12" N71°E 19.8'] [W.PINE 12" N4°E 22.2'] [W.PINE 14" N52°E 19.3']

M-2/3 [MEANDER COR E. LINE SEC 1] Wm. BURT, D.S. - 1841 - MAPLE 6" CORNER TREE [W.PINE 16" S12°W 43 LINKS]  
ROBERT E. SCHMELING-ESCANABA PAPER CO. - 1954 - ID CORNER POSITION FROM "GLO" PINE BT SW-SET 1-1/4" I.P. W/A BRASS CAP STAMPED TO ID THE CORNER POSITION. [B.SPRUCE 8" S16°W 28 LINKS] [W.PINE 10" N72°E 10 LINKS]

B. Description of corner evidence found and/or method applied in restoring or reestablishing corner:

M-1/2 [MC COR E.LINE SEC 1] FOUND IN PLACE A 1" I. P. W/A 3" BRASS CAP STAMPED TO ID THE CORNER POSITION.  
ID CORNER MONUMENT AS THAT SET IN 1965 BY SCHMELING FROM HIS NW AND NE BTS WHICH ARE STILL GREEN WITH THE IRON MARKS PLAIN. ACCEPTED EXISTING MONUMENT AS BEING A CAREFUL AND FAITHFULL REESTABLISHMENT OF THE LOCATION OF THE POSITION OF THE ORIGINAL CORNER.

M-2/3 [MC COR E. LINE SEC 1] FOUND IN PLACE A 1" I.P. W/A 3" BRASS CAP STAMPED TO ID THE CORNER POSITION.  
ID CORNER MONUMENT AS THAT SET IN 1954 BY SCHMELING FROM HIS NE BT WHICH IS STILL GREEN WITH THE FACE BLAZE OVERGROWN. ACCEPTED EXISTING MONUMENT AS BEING A CAREFUL AND FAITHFUL PERPETUATION OF THE POSITION OF THE ORIGINAL CORNER.

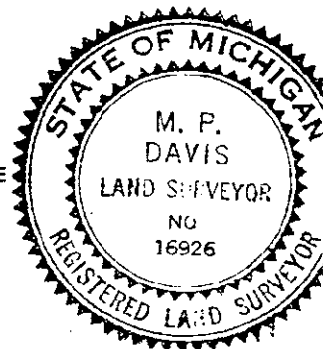

C. Description of monument for corner and accessories established to perpetuate the position of the corner:

M-1/2 DID NOT DISTURB EXISTING MONUMENT  
W.PINE 17"(OLD BT) W.PINE 15"(OLD BT) W.PINE 14" SURVEY MONUMENT SIGN POST  
N52°W N04°E S03°E  
19.28' 22.07' 11.50'  
EAST  
0.86' (TO FACE)

M-2/3 DID NOT DISTURB EXISTING MONUMENT  
W.PINE 19" (OLD BT) HEMLOCK 14" CEDAR 08" SURVEY MONUMENT SIGN POST  
N72°E S06°E S23°W  
6.55' 19.77' 27.95'  
NORTH  
1.40' (TO FACE)

NOTE: BEARINGS TO REFERENCE OBJECTS ARE MAGNETIC-DISTANCES ARE TO A NAIL W/A DELTA COUNTY REFERENCE TAG, UNLESS OTHERWISE NOTED.

Signed by M.P. Davis  
Surveyor's Michigan License No. 16926

Date 12/20/99