

MAY 07 1997

COMMISSION

LAND CORNER RECORDATION CERTIFICATE
Filing Requirement of Act 74, Mich. P.A. 1970

RECORDED

1996 DEC 18 AM 11:17

For corners in
DICKINSON

(County)

WAUCEDAH TWP.

Located In:

Corner Code #

REGISTER OF DEEDS
DICKINSON COUNTY
IRON MOUNTAIN, MI 49801

1. Public Land Survey

T 40N R 28W

K-7

K-8

2. Property Controlling
in Section

S T R

S T R

3. Miscellaneous

S T R

Property in Section

S T R

23

Register of Deeds Stamp & File Number

4. Lot No. _____, Recorded Plat _____

5. Private Claims _____

	A	B	C	D	E	F	G	H	I	J	K	L
2	6	5	4	3	2	1						
3												
4	7	8	9	10	11	12						
5												
6	18	17	16	15	14	13						
7												
8	19	20	21	22	23	24						
9												
10	30	29	28	27	26	25						
11												
12	31	32	33	34	35	36						
13												

I, ROBERT F. PERKINS,in a field survey on 10-23, 19 96

do hereby certify that under requirements of P.A. 74, Michigan P.A. of 1970, the corner points mentioned in lines 1 and 2 above were in conformance with regulations and rules therefore as required in the current manual of survey instructions of the United States Department of the Interior, Bureau of Land Management or by a decree of a Court of Law and/or that the corner points mentioned in lines 3, 4 and 5 above were in conformance with the rules of the Michigan Board of Professional Surveyors or by a Decree of a Court of Law; established, re-established, monumented, re-monumented, recovered, found as expressed below:

NOTE: Not more than 4 corners, all in the same town and range, may be recorded on this certificate.

A. Description of original monument and accessories and/or subsequent restoration:

K-7 CORNER COMMON TO SECTIONS 13-14-23-24

POST BY J. H. MULLETT, D.S. 1849
ORIGINAL BEARING TREES
W. PINE 14" S18°E 30 L.
Y. PINE 28" S64°W 21 L.

K-8 1/4 CORNER COMMON TO SECTIONS 23-24

POST BY J. H. MULLETT, D.S. 1849
ORIGINAL BEARING TREES
FIR 6" S78°E 26 L.
FIR 4" N29°W 56 L.

B. Description of corner evidence found and/or method applied in restoring or reestablishing corner:

K-7 FOUND 1" IRON PIPE WITH 4" D.N.R.
BRASS CAP SET BY B. BUCKLER IN 1960
(#421) AT OLD WOOD STAKE AND IRON BAR.
1960 BEARING TREES
SPRUCE 10" S77°E (M.B.) 89 L. (FOUND)
BALSAM 7" N35°E (M.B.) 40 L.
MAPLE 5" N65°W (M.B.) 39 L. (FOUND)

K-8 FOUND 1" IRON PIPE WITH 4" D.N.R. BRASS
CAP SET BY B. BUCKLER AT FOUND IRON PIPE
AND WOOD POST IN 1960 (#334).
1960 BEARING TREES
B. ASH 9" N78°W 63 L.
S. MAPLE 4" S18°E 15 L.

ACCEPTED BY THE DICKINSON COUNTY
SURVEY PEER GROUP AS THE OFFICIAL
CORNER UNDER MICHIGAN PUBLIC ACT
346 OF 1980 AT A MEETING HELD ON

12-17-96
RFP

COUNTY REPRESENTATIVE

C. Description of monument for corner and accessories established to perpetuate locating the position of the corner:

K-7 ACCEPTED ABOVE DESCRIBED MONUMENT
NEW BEARING TREES:
MAPLE 9" N88°E (M.B.) 32.48' NAIL/TAG
MAPLE 12" N65°W (M.B.) 25.44' OLD B.T.
SPRUCE 20" S73°E (M.B.) 58.95' OLD B.T.
PINE STUMP S72°W (M.B.) 9.0'
PLACED CARSONITE MARKER 1.0' NORTH OF
EXISTING CORNER.

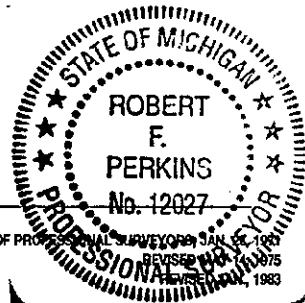
K-8 ACCEPTED ABOVE DESCRIBED MONUMENT.
NEW BEARING TREES:
B. ASH 12" N76°W (M.B.) 41.65' OLD B.T.
S. MAPLE 12" S62°E (M.B.) 15.23' NAIL/TAG
FIR 4" N28°E (M.B.) 17.2' NAIL/TAG
FIR 5" N13°W (M.B.) 20.12' NAIL/TAG
SET CARSONITE STAKE 1.0' NORTH OF
EXISTING CORNER.

Signed by



Date NOVEMBER 6, 1996

Surveyor's Michigan License No. 12027

FORM APPROVED BY MICHIGAN STATE BOARD OF PROFESSIONAL SURVEYORS JAN. 24, 1995
REVISED MAY 1975
REVISION 1983

Liber 2

Page 112