

MICHIGAN
DEPARTMENT OF CONSERVATION
FORESTRY DIVISION

LAND CORNER RECORD

T. 40. NR. 28. W. . .

. . . Dickinson COUNTY

DESCRIPTION OF CORNER . . . 1/4 Section Corner on West side Section 30 . . .

DESCRIPTION OF CORNER MONUMENT 1" pipe with 4" brass cap.

WITNESSES TO CORNER . . . 8" Balsam . . . S 11° W . . . 8 links

. . . 20" Cedar Stp. . . N 15° E . . . 23 links

DESCRIPTION IN DETAIL AS TO HOW CORNER WAS LOCATED AND IDENTIFIED OR
RESTORED.

Replaced 1/4 Section Corner on West side 30.

Two Cedar stp. bottoms in proper position.


Rock ledge 50 links South.

Found old stake bottom in place.

1/4 Corner is 53 links South and 26 links East of 40.00 ch. marker from North.

Corner placed and witnessed August 10, 1955.

SURVEYORS SEAL

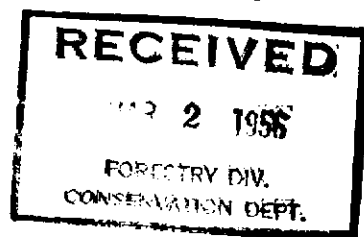

SIGNED

Billy D. Buckles
REGISTERED LAND SURVEYOR

DATE 2/27/56