

MICHIGAN  
DEPARTMENT OF CONSERVATION  
FORESTRY DIVISION

LAND CORNER RECORD

T.40.. NR..28..W


Dickinson COUNTY

DESCRIPTION OF CORNER West 1/8 corner for Section 24 .....

DESCRIPTION OF CORNER MONUMENT 1" x 48" Iron Pipe .....

WITNESSES TO CORNER 6" Cedar (BT) N 69° E 21 Links .....

8" Cedar (BT) N 51° W 37 Links .....

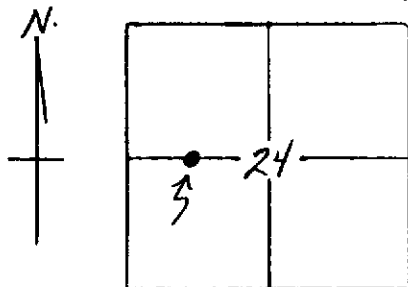

DESCRIPTION IN DETAIL AS TO HOW CORNER WAS LOCATED AND IDENTIFIED OR  
RESTORED. This corner was established midway between center of  
Section and the west 1/4 corner.

Corner was placed and witnessed January 19, 1960 with Toivo Kauma,  
Assistant District Forester.

SURVEYORS SEAL

SIGNED Billy D. Buckler .. DATE 2/23/60  
REGISTERED LAND SURVEYOR  
Billy D. Buckler