

SURVEY & REMONUMENTATION

MAY 07 1997

LAND CORNER RECORDATION CERTIFICATE Filing Requirement of Act 74, Mich. P.A. 1970

1677 9⁰⁰ RECORDED
1996 SEP 26 AM 9:22

For corners in **COMMISSION**

Dickinson
(County)

Located In:

Corner Code #

1. Public Land Survey T 41N R 28W
2. Property Controlling S T R
3. Miscellaneous S T R
- Property in Sec. S T R

C-9, D-9 & E-9

REGISTER OF DEEDS
DICKINSON COUNTY
IRON MOUNTAIN, MI 49801

Register of Deeds Stamp & File Number

4. Lot No. , Recorded Plat
5. Private Claims

I, Edward Kazianka, in a field survey on August 1, 1996, do hereby certify that under requirements of P.A. 74, Michigan P.A. of 1970, the corner points mentioned in lines 1 and 2 above were in conformance with regulations and rules therefore as required in the current manual of survey instructions of the United States Department of the Interior, Bureau of Land Management or by a decree of a Court of Law and/or that the corner points mentioned in lines 3, 4 and 5 above were in conformance with the rules of the Michigan Board of Land Surveyors or by a Decree of a Court of Law; established, re-established, monumented, re-monumented, recovered, found as expressed below:

NOTE: Not more than 4 corners, all in the same town and range, may be recorded on this certificate.

A. Description of original monument and accessories and/or subsequent restoration:

- C-9 Northwest Corner of Section 29.
Wood Post by John Burt, D.S. 1850.
Hemlock 16" S46W 35 Lks. W Pine 8" N69E 18 Lks.
- D-9 North $\frac{1}{4}$ Corner of Section 29.
Wood Post by John Burt, D.S. 1850.
Y. Birch 16" S56E 16 Lks. Y. Birch 8" N50W 03 Lks.
- E-9 Northeast Corner of Section 29.
Wood Post by John Burt, D.S. 1850.
Cedar 16" S46W 31 Lks. Cedar 14" N41E 25 Lks.

B. Description of corner evidence found and/or method applied in restoring or reestablishing corner:


- C-9 Found Dept. of Conservation Pipe & Cap set by Wm. Buckler on July 15, 1955.
Oak 10" S85E 71 Lks. (Tree cut but stump remains).
Aspen 8" N58W 61 Lks. (Tree gone).
Corner recorded on Page 89 in the office of the Dickinson County Road Commission.
- D-9 No evidence of Original Corner or Accessories found. Set corner by Proportionate Measurement at mid-point and on line btwn. section corners $\frac{1}{2}$ mile to the east & west.
- E-9 Found Dept. of Conservation Pipe & Cap set by Wm. Buckler on July 15, 1955.
W. Birch 9" N25W 16 Lks. (Tree gone).
W. Birch 8" S10E 32 Lks. (Tree dead but still standing).
Corner recorded on Page 88 in the office of the Dickinson County Road Commission.

C. Description of monument for corner and accessories established to perpetuate locating the position of the corner:

- C-9 Dept. of Conservation Pipe & Cap. Set Carsonite Stake 3.0 feet North.
Red Pine 4" N27W 16.35 feet. W. Pine 17" S86E 78.40 feet.
Spruce 3" S57E 43.65 feet. Aspen 5" S82W 27.80 feet.
- D-9 Set $2\frac{1}{2}$ " Dickinson County Remonumentation Monument. Set Carsonite Stake 3.0 feet North.
Aspen 6" N63W 12.64 feet. Aspen 7" N60E 12.48 feet.
R. Pine 3" S35E 25.74 feet. R. Pine 4" S25W 8.81 feet.
- E-9 Dept. of Conservation Pipe & Cap. Set Carsonite Stake 4.0 feet North.
B. Ash 6" S12W 24.10 feet. Spruce 8" S21E 16.00 feet.
Spruce 16" N43E 49.20 feet. W. Birch 8" N 06E 71.00 feet.

Signed by Edward Kazianka Date August 27, 1996
Surveyor's Michigan License No. 14765

FORM APPROVED BY MICHIGAN STATE BOARD OF LAND SURVEYORS, JAN. 28, 1971
REVISED MAY 14, 1975
REVISED JAN., 1983

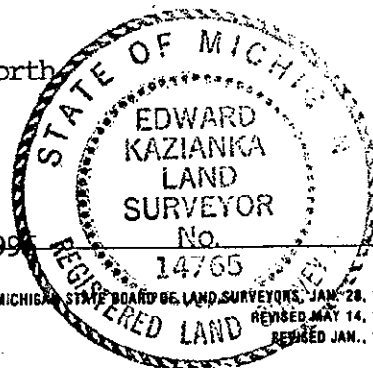

COUNTY REPRESENTATIVE
12 P.P.
9-11-96
ACCEPTED BY THE DICKINSON COUNTY
TOWNSHIP PLANNING GROUP AS THE OFFICIAL
CORNER UNDER MICHIGAN PUBLIC ACT
346 OF 1960 AT A MEETING HELD ON

	A	B	C	D	E	F	G	H	I	J	K	L	M
2	6		5		4		3		2		1		
3													
4	7		8		9		10		11		12		
5													
6	18		17		16		15		14		13		
7													
8	19		20		21		22		23		24		
9													
10	30		29		28		27		26		25		
11													
12	31		32		33		34		35		36		
13													

211