

MICHIGAN  
DEPARTMENT OF CONSERVATION  
FORESTRY DIVISION

LAND CORNER RECORD

T. 41. NR. 28 W.


Dickinson COUNTY

DESCRIPTION OF CORNER West 1/8 corner of Sec. 33

DESCRIPTION OF CORNER MONUMENT 1" x 48" iron pipe

WITNESSES TO CORNER 5" Hard Maple S 42° W 11 1/2 links  
"B.T."

4" Hard Maple S 44° W 44 links  
"B.T."

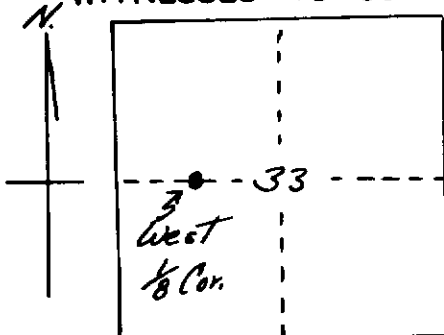

DESCRIPTION IN DETAIL AS TO HOW CORNER WAS LOCATED AND IDENTIFIED OR RESTORED.

Placed west 1/8 corner midway between center of section and west 1/4 corner.

Corner placed and witnessed January 9, 1958.

SURVEYORS SEAL

SIGNED Billy D. Buckles DATE 1/21/58  
REGISTERED LAND SURVEYOR