

LAND CORNER RECORDATION CERTIFICATE
Filing Requirement of Act 74, Mich. P.A. 1970 as Amended

For corners in

Dickinson	Located In:	Corner Code #
(County)		
Norway Township		
1. Public Land Survey	T 41N R 29W	D03
	T R	
	T R	
2. Property Controlling in Section	S T R	
	S T R	
	S T R	
3. Miscellaneous Property in Sec.	S T R	
	S T R	
4. Lot No. , Recorded Plat		
5. Private Claims		

Register of Deeds Stamp & File Number

	A	B	C	D	E	F	G	H	I	J	K	L	M
1													
2	6		5		4		3		2		1		
3													
4	7		8		9		10		11		12		
5													
6	18		17		16		15		14		13		
7													
8	19		20		21		22		23		24		
9													
10	30		29		28		27		26		25		
11													
12	31		32		33		34		35		36		
13													

I, Jeremy J. Pipp, in a field survey on 6/26/2012AD do hereby state that under requirements of P.A. 74, Michigan P.A. of 1970, the corner points mentioned in lines 1 and 2 above were in conformance with regulations and rules therefore as required in the current manual of survey instructions of the United States Department of the Interior, Bureau of Land Management or by a decree of a Court of Law and /or that the corner points mentioned in lines 3, 4 and 5 above were in conformance with the rules of the Michigan Board of Land Surveyors or by a Decree of a Court of Law; established, re-established, monumented, recovered, found as expressed below:

NOTE: Not more than 2 corners, all in the same town and range, may be recorded on this certificate.

A. Description of original monument and accessories and/or subsequent restoration:

(D3) Quarter corner common to Sections 5 and 8, T41N-R29W. 1849: John Burt, DS, Marked 8" Cedar for corner. No BTs are noted. 1951: Michigan DNR (Dean DeLaMater PS#5778) perpetuated Original Corner with a "1 inch pipe with 4" Brass cap. Witnessed by 10" Cedar S84E 35 Links, 8" Cedar S40W 20 Links. Noted Squared tree, original, for corner, still in place, in good condition". 1993: Michigan DNR (Stephan Szyszkoski PS#33986) Found and accepted a scribed wood post at record bearing and distance from DeLaMater's 2 Cedar bearing trees. Iron pipe monument was not recovered. Remonumented the corner with MDNR monument and witnessed: 8" Cedar S02E 5.6', 5" Cedar N56 14.6', EX 8" Cedar S40W 13.2', EX 12" Cedar S84E 22.5'.


B. Description of corner evidence found and/or method applied in restoring or reestablishing corner:

(D03) Accepted found MDNR Monument and Four existing Witnesses (all living). Left MDNR monument in place and rewitnessed (adding nails & BT signs). Position is accepted as a careful and faithful PERPETUATION of the position of the original corner.

C. Description of monument for corner and accessories established to perpetuate locating the position of the corner:

(D03) DNR monument
EX. 14" Cedar S85E 23.09' (1/4S,NBT)
EX. 11" Cedar S01E 6.22' (1/4S,NBT)
EX. 11" Cedar S57W 13.30' (1/4S,NBT)
EX. 8" Cedar N57W 14.72' (1/4S,NBT)
All trees are blazed, scribed, painted, and signed. Measurements are to nail in side of tree, bearings are magnetic. A carsonite rail was set North 1.5 feet.

Signed by Jeremy J. Pipp
Surveyor's Michigan License No. 50447

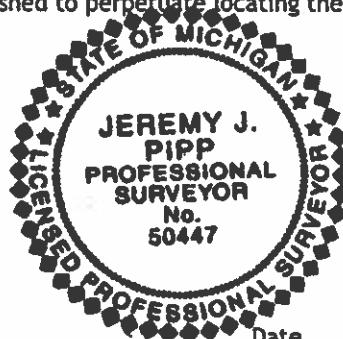

Date July 18, 2012

For the Michigan Department of Natural Resources, Office of Land and Facilities