

LAND CORNER RECORDATION CERTIFICATE  
Filing Requirement of Act 74, Mich. P.A. 1970

RECORDED

1998 DEC 14 PM 12: 25

For corners in

Dickinson

(County)

Norway Twp.

Located In:

Corner Code #

1. Public Land Survey

T 41 R 29W

M-7

T    R   

T    R   

T    R   

T    R   

2. Property Controlling  
in Section

S    T    R   

S    T    R   

3. Miscellaneous  
Property in Sec.

S    T    R   

S    T    R   

REGISTER OF DEEDS  
DICKINSON COUNTY  
RON MOULTON, CLERK

SURVEY &  
REMONUMENTATION

APR 02 1999

Register of Deeds Stamp & File Number

4. Lot No.       , Recorded Plat       

5. Private Claims       

I, Robert F. Perkins, in a field survey on Nov. 3, 19 98 do hereby state that under requirements of P.A. 74, Michigan P.A. of 1970, the corner points mentioned in lines 1 and 2 above were in conformance with regulations and rules therefore as required in the current manual of survey instructions of the United States Department of the Interior, Bureau of Land Management or by a decree of a Court of Law and /or that the corner points mentioned in lines 3, 4 and 5 above were in conformance with the rules of the Michigan Board of Land Surveyors or by a Decree of a Court of Law; established, re-established, monumented, recovered, found as expressed below:

NOTE: Not more than 2 corners, all in the same town and range, may be recorded on this certificate.

	A	B	C	D	E	F	G	H	I	J	K	L	M
1													
2	6		5		4		3		2		1		
3													
4	7		8		9		10		11		12		
5													
6	18		17		16		15		14		13		
7													
8	19		20		21		22		23		24		
9													
10	30		29		28		27		26		25		
11													
12	31		32		33		34		35		36		
13													

A. Description of original monument and accessories and/or subsequent restoration:


M-7 Southeast Corner of Section 13  
Post by W. A. Burt 1846  
Original Bearing Trees  
Sugar 14" S67½°W 24 Lk.  
Lynn 12" N50½°E 50 Lk.

B. Description of corner evidence found and/or method applied in restoring or reestablishing corner:

M-7 No Evidence of Original Corner  
or Accessories Found.  
Found 1" Iron Pipe with 4" D.N.R. Brass Cap  
Set by D.C. DeLaMater, R.L.S. 10-23-1953  
1953 Bearing Trees:  
Spruce 12" S27°W 47 Lk.  
Cedar 18" S13°E 72 Lk.

C. Description of monument for corner and accessories established to perpetuate locating the position of the corner:

M-7 Found and Accepted Pipe Monument described in "B" above.  
Witnesses:  
Cedar 24" S13°E 47.52' Nail (Ex. B.T.)  
Spruce 14" S27°W 31.02' Nail (Ex. B.T.)  
Spruce 10" N45°W 43.15' Nail/Tag  
Spruce 10" S74°W 33.78' Nail/Tag  
Placed Carsonite Marker 0.40' West.

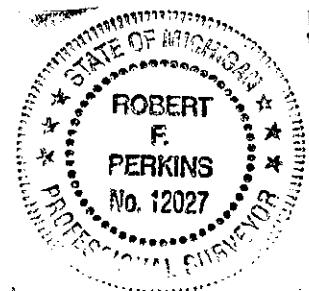

Signed by Robert F. Perkins

Date Nov. 20, 1998

Surveyor's Michigan License No. 12027

RECEIVED BY THE DICKINSON COUNTY  
SURVEY PEER GROUP AS THE OFFICIAL  
CORNER UNDER MICHIGAN PUBLIC ACT  
345 OF 1990 AT A MEETING HELD ON  
12-7-98

R.D. Perkins  
COUNTY REPRESENTATIVE

FORM APPROVED BY MICHIGAN STATE BOARD OF PROFESSIONAL SURVEYORS, JAN. 28, 1971  
REVISED MAY 14, 1975  
REVISED JAN., 1983  
REVISED OCT., 1986

Liber 2 Page 409