

COMMON TO
T41R30W
G13

RECORDED

LAND CORNER RECORDATION CERTIFICATE
Filing Requirement of Act 74, Mich. P.A. 1970

1998 DEC 14 PM 12:24

For corners in

Dickinson

(County)

Located In:

Corner Code #

Breitung Twp.

1. Public Land Survey

T40NR 30W

C-5

G-1

SURVEY &

REMONUMENTATION

2. Property Controlling
in Section

S

T R

NOV 15 1999

3. Miscellaneous
Property in Sec.

S

T R

SECTION

REGISTER OF DEEDS
DICKINSON COUNTY
RON MULLETT, CLERK

Register of Deeds Stamp & File Number

4. Lot No. , Recorded Plat

5. Private Claims

I, Robert F. Perkins, in a field survey on Aug. 18, 19 98 do hereby state that under requirements of P.A. 74, Michigan P.A. of 1970, the corner points mentioned in lines 1 and 2 above were in conformance with regulations and rules therefore as required in the current manual of survey instructions of the United States Department of the Interior, Bureau of Land Management or by a decree of a Court of Law and/or that the corner points mentioned in lines 3, 4 and 5 above were in conformance with the rules of the Michigan Board of Land Surveyors or by a Decree of a Court of Law; established, re-established, monumented, recovered, found as expressed below:

NOTE: Not more than 2 corners, all in the same town and range, may be recorded on this certificate.

	A	B	C	D	E	F	G	H	I	J	K	L	M
1													
2	6		5		4		3		2		1		
3													
4	7		8		9		10		11		12		
5													
6	18		17		16		15		14		13		
7													
8	19		20		21		22		23		24		
9													
10	30		29		28		27		26		25		
11													
12	31		32		33		34		35		36		
13													

A. Description of original monument and accessories and/or subsequent restoration:

C-5 Section Corner Common to Sections 7-8-17-18
Post by James H. Mullett, D.S. 1849
Original Bearing Trees
Aspen 4" S40°W(M.B.) 07 Lk.
Aspen 4" N20°E(M.B.) 05 Lk.

G-1 North Corner between Sections 3 & 4
Post by James H. Mullett, D.S. 1849
Original Bearing Trees
Hemlock 18" S25°E 3 Lk.
Hemlock 18" S15°W 33 Lk.

B. Description of corner evidence found and/or method applied in restoring or reestablishing corner:

C-5 No Evidence of Original Corner
or Accessories Found.
Found 1-3/4" Iron Pipe Referred to in
Certificate Recorded in Liber 2, P. 21
and 3 Witnesses.

G-1 Found 1" Iron Pipe with 4" Brass Cap
D.N.R. Marker set by B.D. Buckler,
RLS on 7-27-1955 and Filed on old
Corner Report No. 117. Corner is
located 1" North of Corner is
1" North

C. Description of monument for corner and accessories established to

C-5 Replaced Iron Pipe referred to "B"
with 2 1/2" Stamped D.C. Remon. Co
New Witnesses
P.Pole #80-20117 S58°E(M.B.) 61.10' Nail/Tag
Cherry 8" N16°W(M.B.) 35.56' Nail/Tag
Cherry 5" N79°W(M.B.) 18.09' Nail/Tag
Spruce 3" S58°W(M.B.) 67.04' Centerline


Described Pipe
1" Iron Pipe 70.37' Nail/Tag
Cherry 3" N75°E(M.B.) 16.52' Nail/Tag
Maple 6" N14°W(M.B.) 27.20' Nail/Tag
J.Pine 10" S67°W(M.B.) 57.52' Nail/Tag
Placed Carsonite Marker 1' North of
Corner.

Signed by Robert F. Perkins Date Oct. 24, 1998

Surveyor's Michigan License No. 12027

ACCEPTED BY THE DICKINSON COUNTY
SURVEY PEER GROUP AS THE OFFICIAL
CORNER UNDER MICHIGAN PUBLIC ACT No. 12027
345 OF 1990 AT A MEETING HELD
12-7-98

R.F. Perkins
COUNTY REPRESENTATIVE

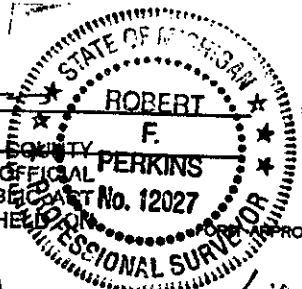

Liber 2 Page 395

REVISOR MAY 14, 1975
REVISED JAN. 1983
REVISED OCT., 1985