

LAND CORNER RECORDATION CERTIFICATE  
Filing Requirement of Act 74, Mich. P.A. 1970 as Amended

For corners in

Dickinson	Located In:	Corner Code #
(County)		
WEST BRANCH TOWNSHIP		
1. Public Land Survey	T 44N R 27W	B05
	T 44N R 27W	C06
	T R	
2. Property Controlling Section	S T R	
	S T R	
	S T R	
3. Miscellaneous Property in Sec.	S T R	
	S T R	
4. Lot No. , Recorded Plat		
5. Private Claims		

Register of Deeds Stamp & File Number

	A	B	C	D	E	F	G	H	I	J	K	L	M
1													
2	6		5		4		3		2		1		
3													
4	7		8		9		10		11		12		
5													
6	18		17		16		15		14		13		
7													
8	19		20		21		22		23		24		
9													
10	30		29		28		27		26		25		
11													
12	31		32		33		34		35		36		
13													

9/24/2013AD  
9/24/2013AD  
do hereby state  
that under requirements of P.A. 74, Michigan P.A. of 1970, the corner points mentioned in lines 1 and 2 above were in conformance with regulations and rules therefore as required in the current manual of survey instructions of the United States Department of the Interior, Bureau of Land Management or by a decree of a Court of Law and /or that the corner points mentioned in lines 3, 4 and 5 above were in conformance with the rules of the Michigan Board of Land Surveyors or by a Decree of a Court of Law; established, re-established, monumented, recovered, found as expressed below:

NOTE: Not more than 2 corners, all in the same town and range, may be recorded on this certificate.

A. Description of original monument and accessories and/or subsequent restoration:

(B05) Quarter corner common to Sections 7 and 18. 1850: John Burt, DS. Set Fir quarter section corner post witnessed by Cedar 10 N34W 22 links (14.52'), Sugar 10 S60E 33 links (21.78'). 1987: Michigan DNR (David Babbitt PS#21558) Set 1" pipe with 4" Aluminum cap witnessed by 5" R. Maple S88W 8.7', 4" Balsam S22W 19.2', 8" Balsam N79E 19.0', 3" Balsam S65E 12.9'.

(C06) Quarter corner common to Sections 17 and 18. 1850: John Burt, DS. Set Ironwood quarter section corner post witnessed by Sugar 14 N53E 24 links (15.84'), Sugar 16 S69W 23 links (15.18'). 1984: Michigan DNR (David Babbitt PS#21558) Set 1" pipe with 4" Aluminum cap witnessed by 10" Maple N81W 42.7', 11" Maple N61E 27.4', 9" Balsam S25E 23.35', 14" Maple S36W 16.1'.

B. Description of corner evidence found and/or method applied in restoring or reestablishing corner:

(B05) Accepted found MDNR Monument and four existing NBT Witnesses (Maple living, Balsam's are dead). Position is accepted as a careful and faithful REESTABLISHMENT of the position of the original corner.

(C06) Accepted found MDNR Monument and three existing NBT Witnesses. Position is accepted as a careful and faithful REESTABLISHMENT of the position of the original corner.


C. Description of monument for corner and accessories established to perpetuate locating the position of the corner:

(B05) DNR monument  
5" Maple N31E 14.41' (1/4S,NBT)  
6" Maple S12E 24.68' (1/4S,NBT)  
EX 8" Maple S89W 8.75' ( - , - )  
5" Maple N65W 31.25' (1/4S,NBT)  
All trees are blazed, scribed, painted, and signed. Measurements are to nail in side of tree, bearings are magnetic. A Carsonite post was set North 1.5 feet.

(C06) DNR monument  
EX 14" Maple N70E 27.90' (1/4S,NBT)  
10" Maple S83E 14.05' (1/4S,NBT)  
EX 16" Maple S44W 16.75' (1/4S,NBT)  
EX 13" Maple N73W 42.70' (1/4S,NBT)  
All trees are blazed, scribed, painted, and signed. Measurements are to nail in side of tree, bearings are magnetic. A Carsonite post was set West 1.5 feet.

Signed by  
Surveyor's Michigan License No. 50447

For the Michigan Department of Natural Resources

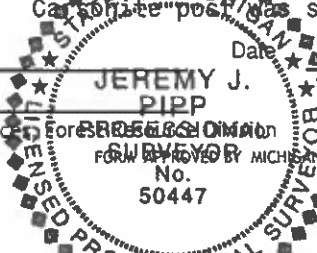

Date October 1, 2013

20297

20298

Revised May 14, 1975  
Revised Jan., 1983  
Revised Oct., 1995