

**LAND CORNER RECORDATION CERTIFICATE**  
**Filing Requirement of Act 74, Mich. P.A. 1970 as Amended**

or corners in

<u>Dickinson</u> (County)	Located In:	Corner Code #
<u>EAST BRANCH TOWNSHIP</u>		
<u>Public Land Survey</u>	T _____ R _____	_____
	T _____ R _____	_____
	T _____ R _____	_____
<u>Property Controlling Section</u>	S <u>10</u> T <u>44N</u> R <u>28W</u>	<u>11</u>
	S <u>10</u> T <u>44N</u> R <u>28W</u>	<u>12</u>
	S _____ T _____ R _____	_____
<u>Miscellaneous Property in Sec.</u>	S _____ T _____ R _____	_____
	S _____ T _____ R _____	_____

Lot No. \_\_\_\_\_, Recorded Plat \_\_\_\_\_  
 Private Claims \_\_\_\_\_

9/03/2014

Jeremy J. Pipp, in a field survey on 9/03/2014 do hereby state

that under requirements of P.A. 74, Michigan P.A. of 1970, the corner points mentioned in lines 1 and 2 above were in conformance with regulations and rules therefore as required in the current manual of survey instructions of the United States Department of the Interior, Bureau of Land Management or by a decree of Court of Law and /or that the corner points mentioned in lines 3, 4 and 5 above were in conformance with the rules of the Michigan Board of Land Surveyors or by a Decree of a Court of Law; established, re-established, monumented, recovered, found as expressed below:

NOTE: Not more than 2 corners, all in the same town and range, may be recorded in this certificate.

1. Description of original monument and accessories and/or subsequent restoration:

(11) Southwest One-Sixteenth corner of Section 10. Not set in original survey, no evidence of subsequent establishment.

(12) Center-South One-Sixteenth corner of Section 10. Not set in original survey, no evidence of subsequent establishment.

2. Description of corner evidence found and/or method applied in restoring or reestablishing corner:

(11) Corner position established at the intersection of the South and West One-Sixteenth lines of Section 10. Monument is located at the base of steep slope to the East.

(12) Corner position established mid-point and on-line between the Center One-Quarter corner and the South One-Quarter corner of Section 10. Location is +/- 10 feet North of Woods road.

C. Description of monument for corner and accessories established to perpetuate locating the position of the corner:


(11) DNR monument  
 6" Cedar N38E 21.91' (1/16S,BT)  
 25" R. Pine S56E 6.67' (1/16S,BT)  
 14" Tamarack S10E 28.43' (1/16S,BT)  
 14" Cedar N02W 33.70' (1/16S,BT)

All trees are blazed, scribed, and painted. Measurements are to nail in side of tree, bearings are magnetic.

Signed by Jeremy J. Pipp  
 Surveyor's Michigan License No. 50447

For the Michigan Department of Natural Resources Forest Resource Division

(12) DNR monument  
 15" J. Pine N15E 43.32' (1/16S,BT)  
 13" J. Pine S71E 3.15' (1/16S,BT)  
 4" J. Pine S54W 17.55' (1/16S,BT)  
 13" R. Tamarack N33W 46.65' (1/16S,BT)  
 All trees are blazed, scribed, and painted. Measurements are to nail in side of tree, bearings are magnetic.

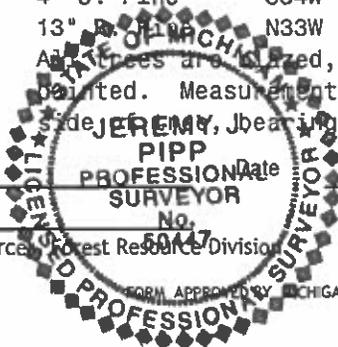

Date September 10, 2014

Register of Deeds Stamp & File Number

	A	B	C	D	E	F	G	H	I	J	K	L	M
1													
2	6		5		4			3		2			1
3													
4	7		8		9			10		11			12
5													
6	10		17		16			15		14			13
7													
8	19		20		21			22		23			24
9													
10	30		29		28			27		26			25
11													
12	31		32		33			34		35			36
13													