


LAND CORNER RECORDATION CERTIFICATE
Filing Requirement of Act 74, Mich. P.A. 1970 as Amended

For corners in

<u>Dickinson</u> (County)	Located In:	Corner Code #	
1. Public Land Survey	T _____ R _____		
	T _____ R _____		
	T _____ R _____		
2. Property Controlling in Section	S <u>21</u> T <u>44N</u> R <u>30W</u>		<u>AMC Govt Lot 6</u>
	S _____ T _____ R _____		
	S _____ T _____ R _____		
3. Miscellaneous Property in Sec.	S _____ T _____ R _____		
	S _____ T _____ R _____		
4. Lot No. _____, Recorded Plat _____			
5. Private Claims _____			

Register of Deeds Stamp & File Number

1	A	B	C	D	E	F	G		
2		6		5		4			
3									
4		7		8		9			
5									
6		18		17		16			
7									
8		19		20		21			
9									
10		30		29		28			
11									
12		31		32		33			
13									

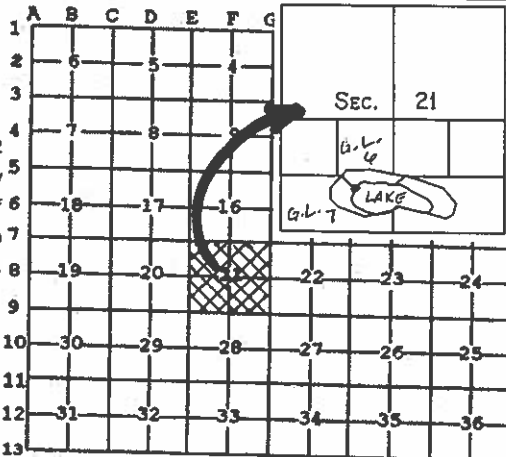

I, Stephan J. Szyszkoski, in a field survey on 04/11/2011 do hereby state that under requirements of P.A. 74, Michigan P.A. of 1970, the corner points mentioned in lines 1 and 2 above were in conformance with regulations and rules therefore as required in the current manual of survey instructions of the United States Department of the Interior, Bureau of Land Management or by a decree of a Court of Law and /or that the corner points mentioned in lines 3, 4 and 5 above were in conformance with the rules of the Michigan Board of Land Surveyors or by a Decree of a Court of Law; established, re-established, monumented, recovered, found as expressed below:

NOTE: Not more than 2 corners, all in the same town and range, may be recorded on this certificate.

A. Description of original monument and accessories and/or subsequent restoration:

(AMC) Auxiliary Meander Corner at the intersection of the partition line between Government Lots 6 and 7, Sec. 21 with the Ordinary High Water Mark of Long Lake. The position of this corner was not monumented in the original survey and is determined by applying the "proportionate shoreline" method of partitioning accretions, relictions and certain omitted lands as described in the 2009 BLM Manual of Surveying Instructions.

B. Description of corner evidence found and/or method applied in restoring or reestablishing corner:

(AMC) This Auxiliary Meander Corner falls on the shoreline of Long Lake and is the southeasterly terminus of a partition line between Government Lots 6 and 7 under an apportionment of the riparian uplands of said lots. The lands lying between the position of the record GLO meander line and current shoreline of Long Lake were apportioned so as to make the ratio of the combined frontage of Government Lots 6 and 7 to the entire shoreline (being a ratio of 22.4%) equal to the ratio along the line of the record GLO meander course (Sec. 8-133(1) BLM manual). In addition, the partition lines bounding said apportionment are situated so as to award each basic holding on the shore the part of the bed in front of it (Sec. 8-132). The position for the corner falls in the wet margin of Long Lake and was not monumented. I established a witness corner to the AMC on the partition line, as described below. A definite determination of the location of the OHWM was not made in this survey. The Michigan Coordinate System of 1983 grid bearing of the partition line is North 45 deg. 35 min. 49 sec. West.

C. Description of monument for corner and accessories established to perpetuate locating the position of the corner:

(AMC) Set 1"IDx32" I.pipe with 4" alum. MDNR cap approx. 31' NW of the AMC position and on the partition line between G.L. 6 and G.L. 7
Set measuring nail with MDNR tag in the side of:
10" Tamarack N16E 16.0' mrkd "WC BT"
5" Balsam N60E 4.9' do
9" Maple S54W 23.0' do
10" B.Spruce N60W 13.25' do
Set sq'd Cedar post adjacent.
Bearings are magnetic.



Signed by Stephan J. Szyszkoski Date 07/06/2011
Surveyor's Michigan License No. 33986

For the Michigan Department of Natural Resources, Forest Management Division