

FILED
copy

**EATON COUNTY REMONUMENTATION
LAND CORNER RECORDATION CERTIFICATE**
Filing Requirement of Act 74, Mich. P.A. 1970

95 DEC 26 PM 2: 29

For corners in

EATON
(County)

Located In:

Corner Code ##

LINDA M. TWITCHELL
REGISTER OF DEEDS
EATON COUNTY, MICH.

1. Public Land Survey T 3N R 6W C-1
VERMONTVILLE TWP. T _____ R _____
TOWN LINE COR. T _____ R _____
SEC. 5 & 6 T _____ R _____
2. Property Controlling S _____ T _____ R _____
in Section S _____ T _____ R _____
3. Miscellaneous S _____ T _____ R _____
Property in Sec. S _____ T _____ R _____

L.3 pg 660

Register of Deeds Stamp & File Number

4. Lot No. _____, Recorded Plat _____
5. Private Claims _____

I, BRIAN REYNOLDS, in a field survey on 21 JULY, 19 95,
do hereby certify that under requirements of P.A. 74, Michigan P.A. of 1970, the corner points mentioned
in lines 1 and 2 above were in conformance with regulations and rules therefore as required in the
current manual of survey instructions of the United States Department of the Interior, Bureau of Land
Management or by a decree of a Court of Law and/or that the corner points mentioned in lines 3, 4 and 5
above were in conformance with the rules of the Michigan Board of Land Surveyors or by a Decree of a
Court of Law; established, re-established, monumented, re-monumented, recovered, found as
expressed below:

NOTE: Not more than 4 corners, all in the same town and range, may be recorded
on this certificate.

A. Description of original monument and accessories and/or subsequent restoration:

1. GENERAL LAND OFFICE: ORANGE RISDON D.S., DECEMBER 1826. INTERSECT N. BDY. 9 LKS W. OF POST W.
MAPLE 8 S43E 28 (LKS) BEECH 6 S21W 17 (LKS)
 2. COUNTY SURVEYOR OSCAR C. CHURCH: ; "FOUND THIS STONE SET,"
NO WITNESSES, 6 APR 1878 SURVEY OF SECTION 6, VOL. 2, P. 6
 3. PRIVATE NOTES OF NEDERVELD ASSOCIATES, c. 1991, SET CAPPED IRON, NO WITNESSES.
 4. COUNTY SURVEYOR (NO NAME ON DRAWING, VOL. 1, P. 16) DATED APRIL 1868, SECTION 32, T4N R6W, SHOWS
STONE FOR STANDARD CORNER AND ANOTHER STONE 59.23 RODS EAST ON TOWN LINE. SHOWN FOR
REFERENCE PURPOSES ONLY.
- NO OTHER HISTORICAL DATA, PUBLIC OR PRIVATE, COULD BE FOUND FOR THIS CORNER.


B. Description of corner evidence found and/or method applied in restoring or reestablishing corner:

PRELIMINARY FIELD CHECK: FOUND NAIL (TRAVERSE POINT) SET BY NEDERVELD ON C/L - C/L INTERSECTION;
FOUND NEDERVELD IRON TO EAST (NEDERVELD NOTES INDICATE THIS IS INTENDED TO BE C-1, T3N R6W);
FOUND EXCAVATION HOLE BETWEEN NAIL AND IRON +/-3' NORTH. AFTER TRAVERSE TO LOCATE OCCUPATION
LINES, CONCLUDED THAT NEDERVELD HAD APPROXIMATED LOCATION OF C-13 TO SET CLOSING CORNER, THEN
SET CLOSING CORNER EAST OF STANDARD CORNER. COMPUTED MOST PROBABLE LOCATION FOR BOTH
STANDARD AND CLOSING CORNERS, AND ON JULY 14, 1994, EXCAVATED 2' BY 2' AREA THROUGH BLACKTOP AT
BOTH LOCATIONS, FOUND NOTHING. AT DIRECTION OF PEER GROUP, ON JULY 13, 1995, EXCAVATED LARGER
AREA, FOUND STONE. BEING UNSURE IF THE STONE REPRESENTED THE STANDARD OR CLOSING CORNER,
EXCAVATED 5.94 FEET WEST AND EAST, FOUND NOTHING. MEASURED FROM STONE TO OCCUPATION LINE
REPRESENTED IN ITEM #4 ABOVE, FOUND DISTANCE TO BE 994.2' +/- . RECORD DISTANCE TO STANDARD CORNER
IS 988.68 (59 22/25 RODS), TO CLOSING CORNER IS 994.62' (988.68+5.94). FROM THIS, CONCLUDED THAT FOUND
STONE REPRESENTED CLOSING CORNER; REPLACED FOUND STONE WITH STANDARD EATON COUNTY REMON
IRON AND PLASTIC CAP INSCRIBED "PA 345 31602."

SEE REVERSE SIDE OF THIS FORM FOR RELATIVE POSTION OF ADJACENT CORNERS.

C. Description of monument for corner and accessories established to perpetuate locating the position of the corner:

SET STANDARD EATON COUNTY REMON IRON AND PLASTIC CAP INSCRIBED "PA 345 31602" IN MON BOX
SET 20d NAIL W/PLASTIC TAG IN THE WEST SIDE OF A UTILITY POLE N37°W 37.67'
SET 20d NAIL W/PLASTIC TAG IN THE SOUTHEAST SIDE OF AN 8" POPLAR N44°E 49.25'
SET 20d NAIL W/PLASTIC TAG IN THE NORTH SIDE OF A 14" BLACK WALNUT S74°W 103.23'
FOUND NAIL IN THE WEST SIDE OF A 32" OAK S13°E 85.20'
C-13 T4N, R6W, SUNFIELD TOWNSHIP, LIES S89°40'E 5.94'
FOUND 1/2" CAPPED IRON BY NEDERVELD S85°55'E 14.21'
CENTERLINE GRAVEL ROAD NORTH (IRISH ROAD) WEST 3'+/-
CENTERLINE GRAVEL ROAD SOUTH (IRISH ROAD) EAST 2'+/-
CENTERLINE EAST-WEST BITUMINOUS ROADWAY SOUTH 2'+/-

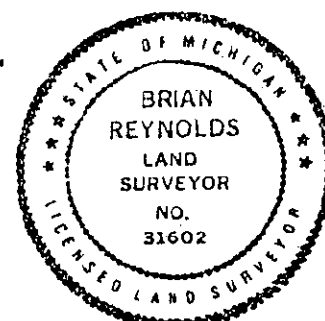

Signed by

Date 12/21/95

Surveyor's Michigan License No. 31602

P.A. 345 EATON COUNTY APPROVED BY MICHIGAN STATE BOARD OF LAND SURVEYORS, JAN. 28, 1971

PEER APPROVED 8/3/95 m

REVISED MAY 14, 1975
REVISED JAN., 1983

TO B-1 N89°39'36"W 2632.42'
TO C-2 S0°11'42"W 2721.84'
TO D-1 S89°32'13"E 2669.40'

h.3

pg 661