

APR 27 1995

1994 REMONUMENTATION PROGRAM

DEED LIBER 2565 PAGE 876

COMMISSION

LAND CORNER RECORDATION CERTIFICATE

Filing Requirement of Act 74, Mich. P.A. 1970

For corners in

GENESEE (County)	Located In:	Corner Code #/
	GAINES	
1. Public Land Survey	T 6N R 5E	L-3
	T R	
	T R	
	T R	
2. Property Controlling in Section	S T R	
	S T R	
3. Miscellaneous Property in Sec.	S T R	
	S T R	
4. Lot No. _____, Recorded Plat _____		
5. Private Claims _____		

Register of Deeds Stamp & File Number

I, RICHARD H. KRAFT, PS, in a field survey on NOVEMBER 10, 19 94, do hereby certify that under requirements of P.A. 74, Michigan P.A. of 1970, the corner points mentioned in lines 1 and 2 above were in conformance with regulations and rules therefore as required in the current manual of survey instructions of the United States Department of the Interior, Bureau of Land Management or by a decree of a Court of Law and/or that the corner points mentioned in lines 3, 4 and 5 above were in conformance with the rules of the Michigan Board of Land Surveyors or by a Decree of a Court of Law; established, re-established, monumented, re-monumented, recovered, found as expressed below:

NOTE: Not more than 4 corners, all in the same town and range, may be recorded on this certificate.

A. Description of original monument and accessories and/or subsequent restoration:

1823 GLO; JOHN MULLETT, D.S. - SET POST - NO ACCESSORIES
1919 GCRC - FOUND STONE - 3 ACCESSORIES
1969 GCRC - FOUND STONE, SET IRON - 6 ACCESSORIES

B. Description of corner evidence found and/or method applied in restoring or reestablishing corner:

1994 GENESEE COUNTY REMONUMENTATION PROGRAM

FOUND 1/2" RE-ROD IN MONUMENT BOX

1 ACCESSORY 1919

Ratified by Peer Group in
accordance with P.A. 345, 1990Co. Rep. Carl H. Carlson
Date 12-28-94


RATIFIED BY GENESEE COUNTY PEER GROUP DECEMBER 28, 1994

C. Description of monument for corner and accessories established to perpetuate locating the position of the corner:

SET STANDARD GENESEE COUNTY MONUMENT IN MONUMENT BOX

ACCESSORIES:

N45°E	65.93'	ROAD SIGN
S 5°W	35.6'	FOUND P.K. & CAP (RLS) IN POWER POLE
N45°W	75.07'	FOUND P.K. & CAP (RLS) #11192 IN POWER POLE
N45°W	59.4'	CORNER OF CONCRETE R/W MONUMENT
SOUTH		OCCUPIED N-S 1/4 LINE, SECTION 12

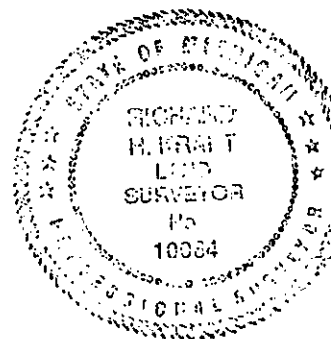

Signed by

Richard H. Kraft

Date

DECEMBER 31, 1994

Surveyor's Michigan License No.

10064