

AUG 23 2000

SECTION

LAND CORNER RECORDATION CERTIFICATE
Filing Requirement of Act 74, Mich. P.A. 1970
Gladwin County Remonumentation

001 PAGE 308

For Corners in
GLADWIN

(County)

Located In:

Corner Code#:

1. Public Land Survey T. 17N R. 2W G-3
T. _____ R. _____
T. _____ R. _____
2. Public Controlling S. _____ T. _____ R. _____
in Section S. _____ T. _____ R. _____
3. Miscellaneous S. _____ T. _____ R. _____
Property in Section S. _____ T. _____ R. _____
4. Lot No. _____, Recorded Plat _____
5. Private Claims _____

STATE OF MICHIGAN
GLADWIN COUNTY
FILED-REMONUMENTATION

10 AUG 2000 11:20:18 AM

BONNIE K. HOUSE
REGISTER OF DEEDS

Register of Deeds Stamp & File Number

I, Mark R. Robison, in a field survey on April 2000, do hereby certify that under requirements of P.A. 74, Michigan P.A. of 1970, the corner points mentioned in lines 1 and 2 above were in conformance with regulations and rules therefore as required in the current manual of survey instructions of the United States Department of the Interior, Bureau of Land Management or by a decree of a Court of Law and/or that the corner points mentioned in lines 3, 4 and 5 above were in conformance with the rules of the Michigan Board of Land Surveyors or by a Decree of a Court of Law, established, re-established, monumented, re-monumented, recovered, found as expressed below.

NOTE: Not more than 2 corners, all in the same town and range, may be recorded on this certificate.

A. Description of original monument and accessories and/or subsequent restoration:

1850 William B. Burt
Set Post Cor Sec's 3, 4, 9 & 10
Wit-(1)W. Pine 30 S71E 41
(2)Beech 8 S70W 25

1976 Lapham--working dwg

1979 Lapham--survey
Wit-same as (3), (4), (5)

1987 Lapham--survey, working dwg
same as (7), (8), (9)

1971 Lapham--Found Iron Stake
LCRC#25, survey, working drawing
Wit-(3)S67°W - 117.05' 14" Oak
(4)N50°E - 44.8' Fence Post
(5)N42°W 70.2' C.M.P.
(6)N45°W P.P. 70.2'

1983 Lapham--survey
Found Nail Re-Set ½" Capped Re-Rod
Wit-(7)N45°W, 70.52' - Power Pole
(8)N05°W, 33.16' - East Gate Post
(9)S45°W, 47.00' - Corner Post

1998 Lapham--survey, working dwg
same as (7), (8), (9)

APPROVED LAND CORNER
P.A. 345 of 1990
Gladwin County

Co. Rep. John M. Miller

Date 8-9-00

B. Description of corner evidence found and/or method applied in restoring or re-establishing corner:

Found 1/2" x 18" iron in centerline of East-West road and centerline of old road R/W to North & South. Found witness (3) Recorded 117.05', measured 116.95'--no witness material found on 36" Oak, set nail & tag. Agrees with Lapham measurement to F-3 (1971) 2650.47' & (1998) 2650.50'. Accepted ½" iron as corner of record; replaced with 5/8" x 36" rerod.


See dossier for detailed report on corner G-3.

C. Description of monument for corner and accessories established to perpetuate locating the position of the corner:

Set 5/8" x 36" rerod with Gladwin Remonumentation cap marked P.S. 27458. Accepted as best available evidence to perpetuate position of corner G-3.

Witnesses:

S70°W 36" Oak, nail & tag 116.95' (OBT)
N45°W Power Pole, nail & tag, 68.20'
N25°E 10" Ash, nail & tag, 93.42'
S45°E 8" Maple, nail & tag 78.40'
South, C.I.#9133, 33.00'

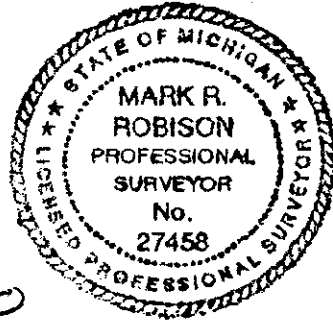

Signed by Mark R. Robison

Surveyor's Michigan License No. 27458

Date 8-9-00