

LAND CORNER RECORDATION CERTIFICATE

Filing Requirement of Act 74, Mich. PA 1970

Gladwin
(County)

Located In

Corner Code #

1. Public Land Survey

T	18N	R	1E	M1
T	18N	R	2E	A1
T	19N	R	1E	M13
T	19N	R	2E	A13
T		R		
T		R		


4. Lot No: Recorded Plat:

5. Private Claims:

I, Craig W. McVean, in a field survey on Feb. 14, 2011 do hereby state that under requirements of PA 74, Michigan PA of 1970, the corner points mentioned in lines 1 and 2 above were in conformance with regulations and rules therefore as required in the current manual of survey instructions of the United States Department of the Interior, Bureau of Land Management or by a decree of a Court of Law and/or that the corner points mentioned in lines 3, 4 and 5 above were in conformance with the rules of the Michigan Board of Land Surveyors or by a Decree of a Court of Law; established, re-established, monumented, recovered, found as expressed below:

NOTE: Not more than 2 corners, all in the same town and range, may be recorded on this certificate.

Register of Deeds Stamp & File Number

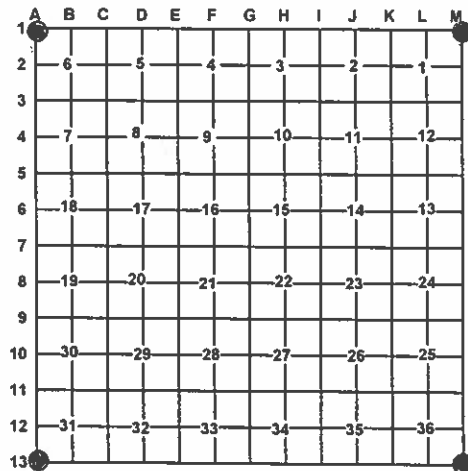

A. Description of original monument and accessories and/or subsequent restoration:

A1 – A13 – M1 – M13 – 1837 – GLO – L. Clason – Set Post

- 1) W. Ash 6" S22°W 16 L.
 - 2) Fir 5" S72°W 27 L.
 - 3) B. Ash 9" N17½°W 74 L.
- 1930's – CCC Notes – Random line from East 323.64 to random post. 99 L. South of original post.
- 4) Witness hole N50°E 50
 - 5) Witness hole S50°W 50
- 1997 – LCRC # 435 - C. Kiiskila – Fd. old rusty 1 ½" pipe with top broke off. Corner probably set by Conservation Dept.

Forester and Surveyor Marcus Schaaf. Cor. Fits GLO swamp calls. Fd. 1 ½" pipe replaced with 1" x 72" Galv. pipe with 4" Alum. DNR Cap. Drove Blue Carsonite Post.

- 6) 15" Maple N87°W 39.08' (Drove Spike & Tag S. Side)
- 7) 6" Maple N45°W 45.52' (Drove Spike & Tag SW Side)
- 8) 6" B. Ash N58°E 18.41' (Drove Spike & Tag)
- 9) 7" Maple S18°E 54.18' (Drove Spike & Tag)
- 10) 6" Maple S30°W 9.30' (Drove Spike & Tag NW Side)

B. Description of corner evidence found and/or method applied in restoring or re-establishing corner:

A1 – A13 – M1 – M13 – Township corner common to Section 1, T18N, R1E, Section 6, T18N, R2E, Section 36, T19N, R1E and Section 31, T19N, R2E – Found 4" DNR Alum. Cap on 1" iron pipe per C. Kiiskila LCRC in Tag Elder swamp. Measured North 75'±10 (GLO-66') to Edge of Swamp. No GLO evidence. No evidence of Witnesses holes – Under ice. DNR Monument accepted as the best available evidence of the position of the original corner.

C. Description of monument for corner and accessories established to perpetuate locating the position of the corner:

A1 – A13 – M1 – M13 – 4" DNR Aluminum Cap on 1" galv. iron pipe – 1.7' above grade. Fd. Blue Carsonite Post 1' East

- N54°E 18.40' to Fd. N & T in NW side 8" Ash (#8)
- S16°E 54.18' to Fd. N & T in E. side 12" Red Maple (#9)
- S32°W 9.25' to Fd. N & T in NW side Tw. 8" & 4" Red Maple (#10)
- N86°W 39.10' to Fd. N & T in S. side 18" Red Maple (#6)
- N42°W 45.53' to Fd. N & T in SW side 12" Red Maple (#7)



Signed by:

Craig W. McVean

Date:

1/26/2012

Surveyor's Michigan License No.:

39088